


T.4S.R.3W.W.M.

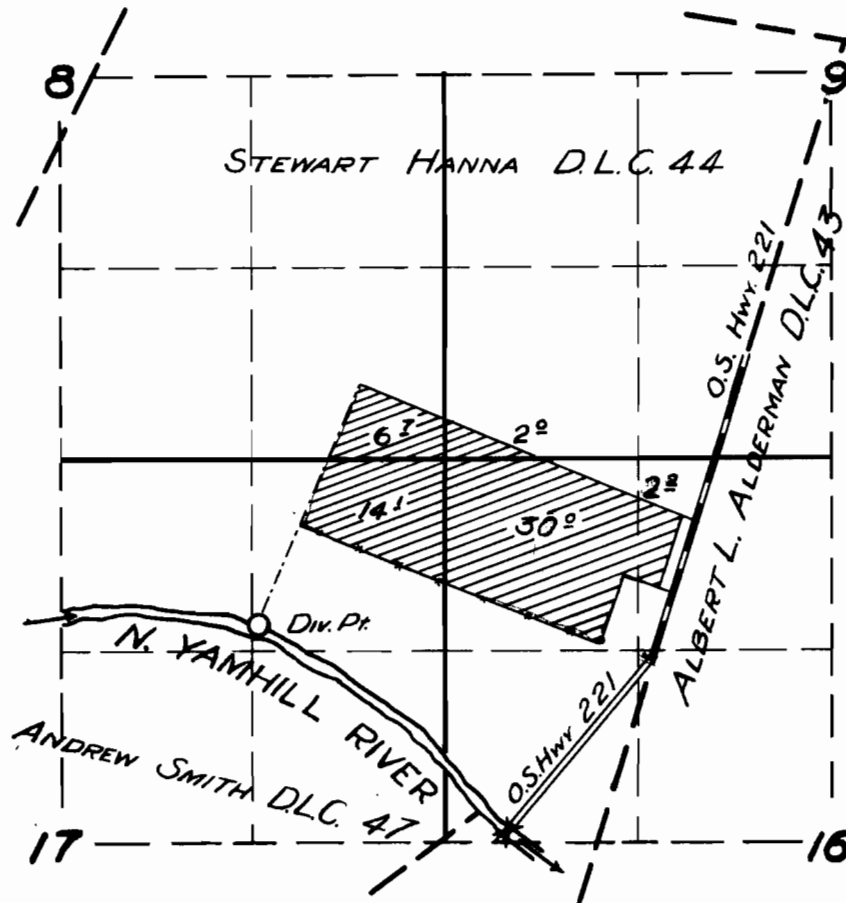

FINAL PROOF SURVEY

UNDER

Application No. 27668 Permit No. 21788

IN NAME OF

HARRY M. and/or MYONA M. GRAY

Surveyed 19 Sep 1955, by *J. B. White*