


T.10S, R.10W. W.M.

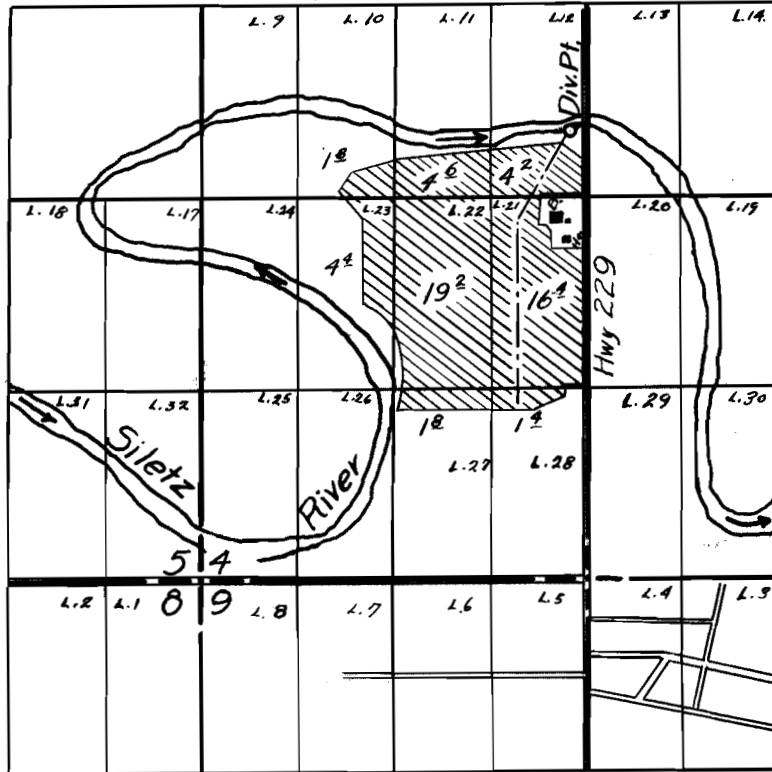

**FINAL PROOF SURVEY**

UNDER

Application No. **27854** Permit No. **21904**  
IN NAME OF

**E. E. COLVIN**

Surveyed **26 August 1955**, by *R. H. [Signature]*