
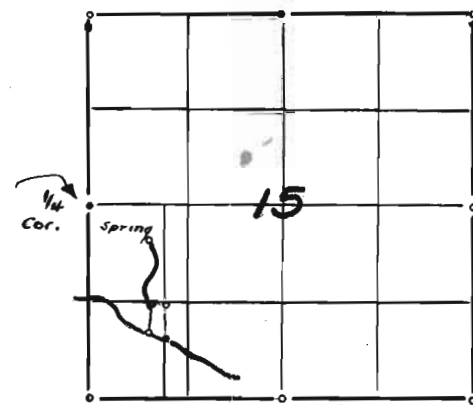


1/4 SECTION CORNER EAST 990.0'


SECTION 16
SECTION 15

5. 10 02' 30" N.

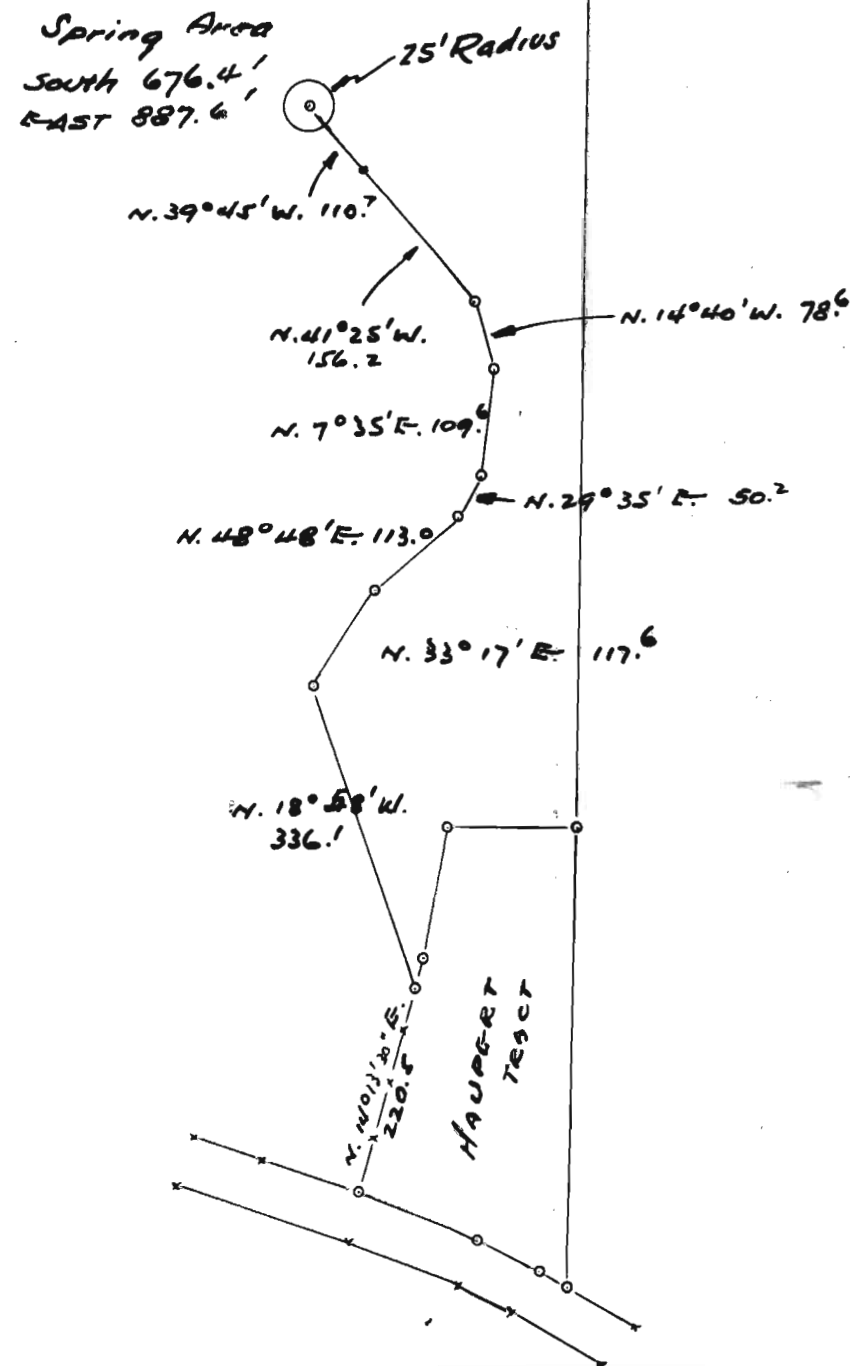

T. 15. R. 9 W. W. M.
LOCATION SKETCH

app 28151
Per 22156

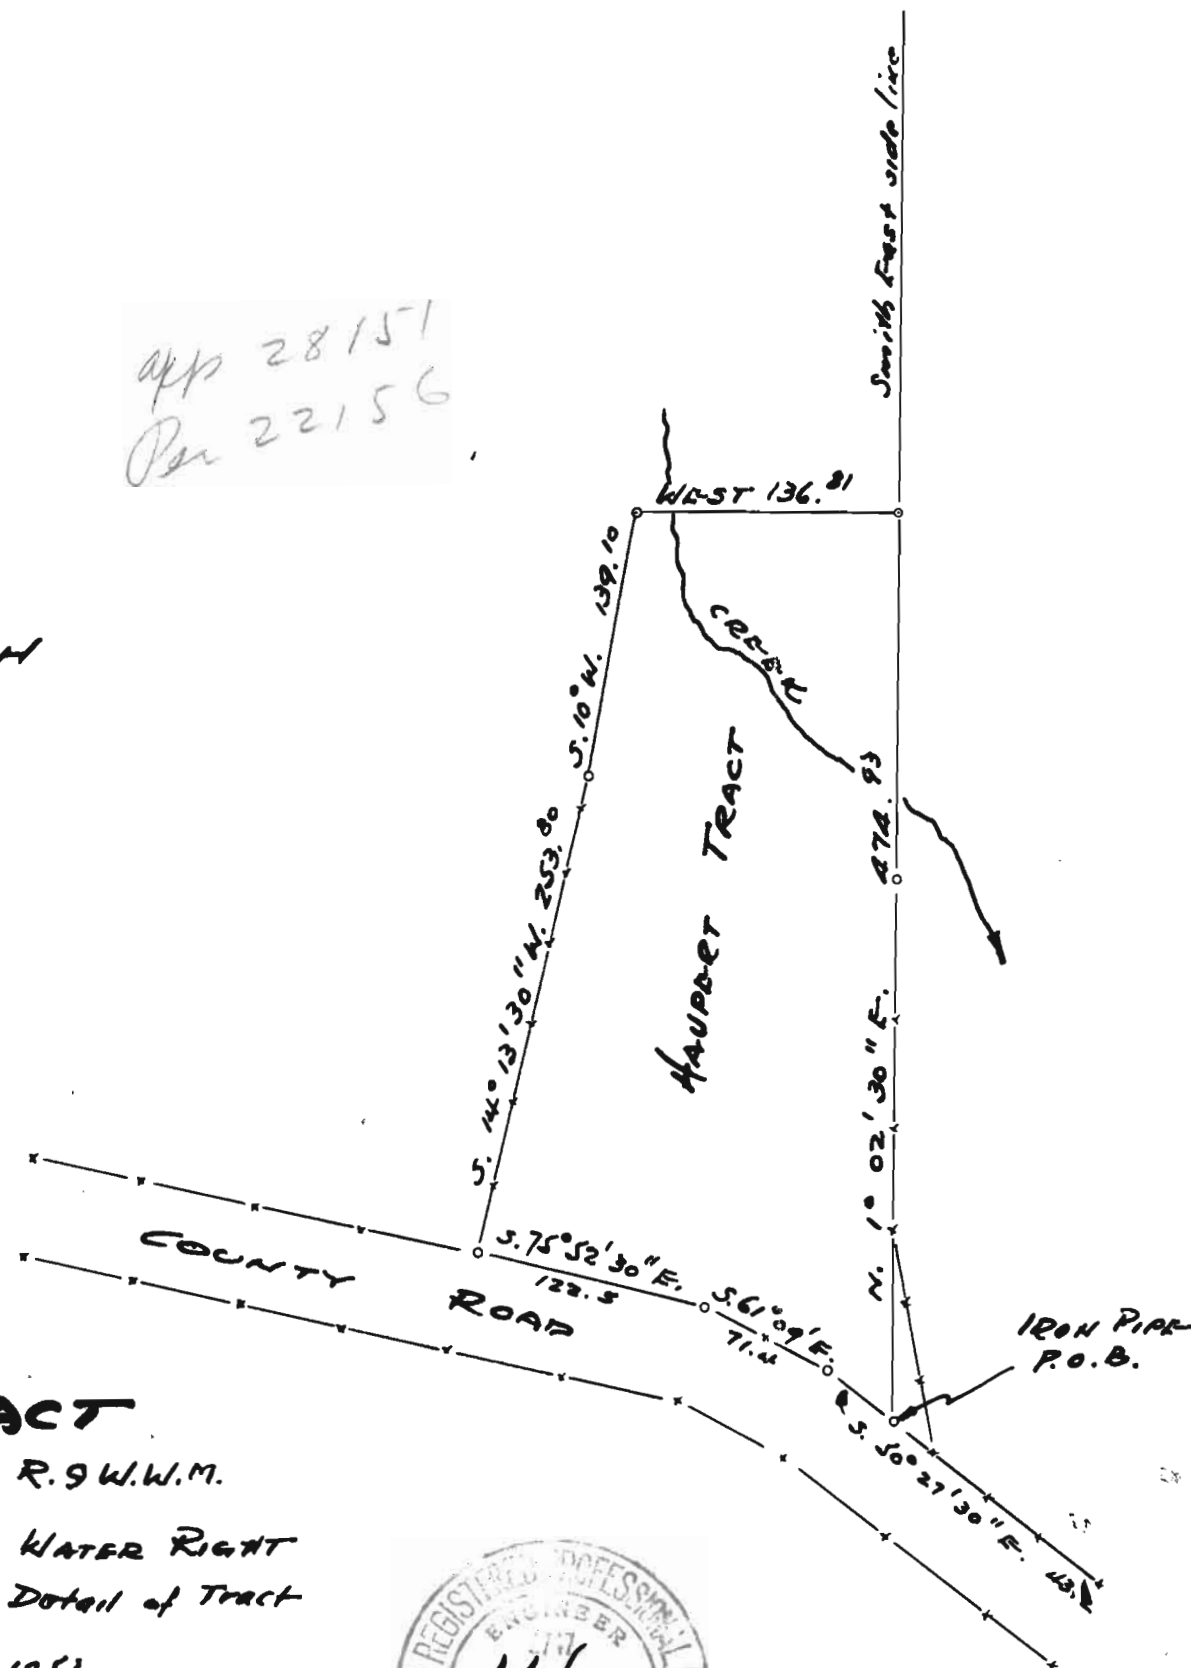

HAUPERT TRACT
SW 1/4 SW 1/4 SECTION 15 T. 15. R. 9 W. W. M.
Scale 1 inch = 200 feet WATER RIGHT
1 inch = 100 feet Detail of Tract
Feb. 1953.



South 1851.00
East 936.50
from 1/4 Section Corner
SECTIONS 15 & 16
T. 15. R. 9 W. W. M.

Application No. 28151
Permit No. 22156