


T55R10WWM

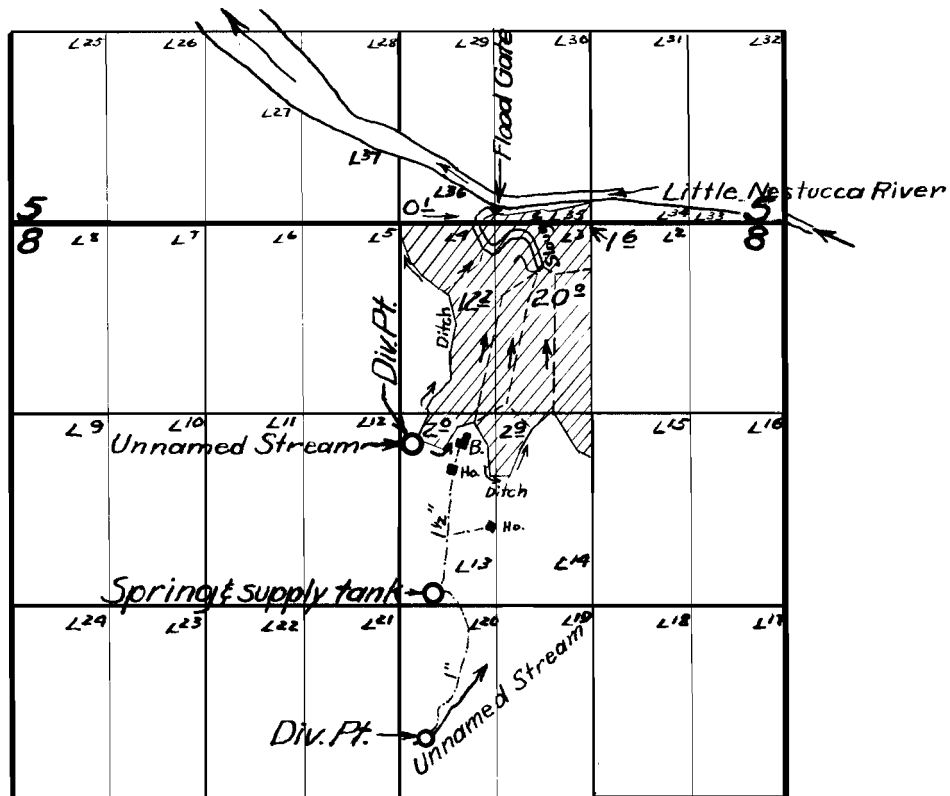

FINAL PROOF SURVEY

UNDER

18998

14699

Application No. 28164 Permit No. 22164

IN NAME OF

Ora L. & Jessie M. Ray

Surveyed Sept. 14 1955 by M. Bish

1955M