


T. 2 S. R. 2 E. W.M.

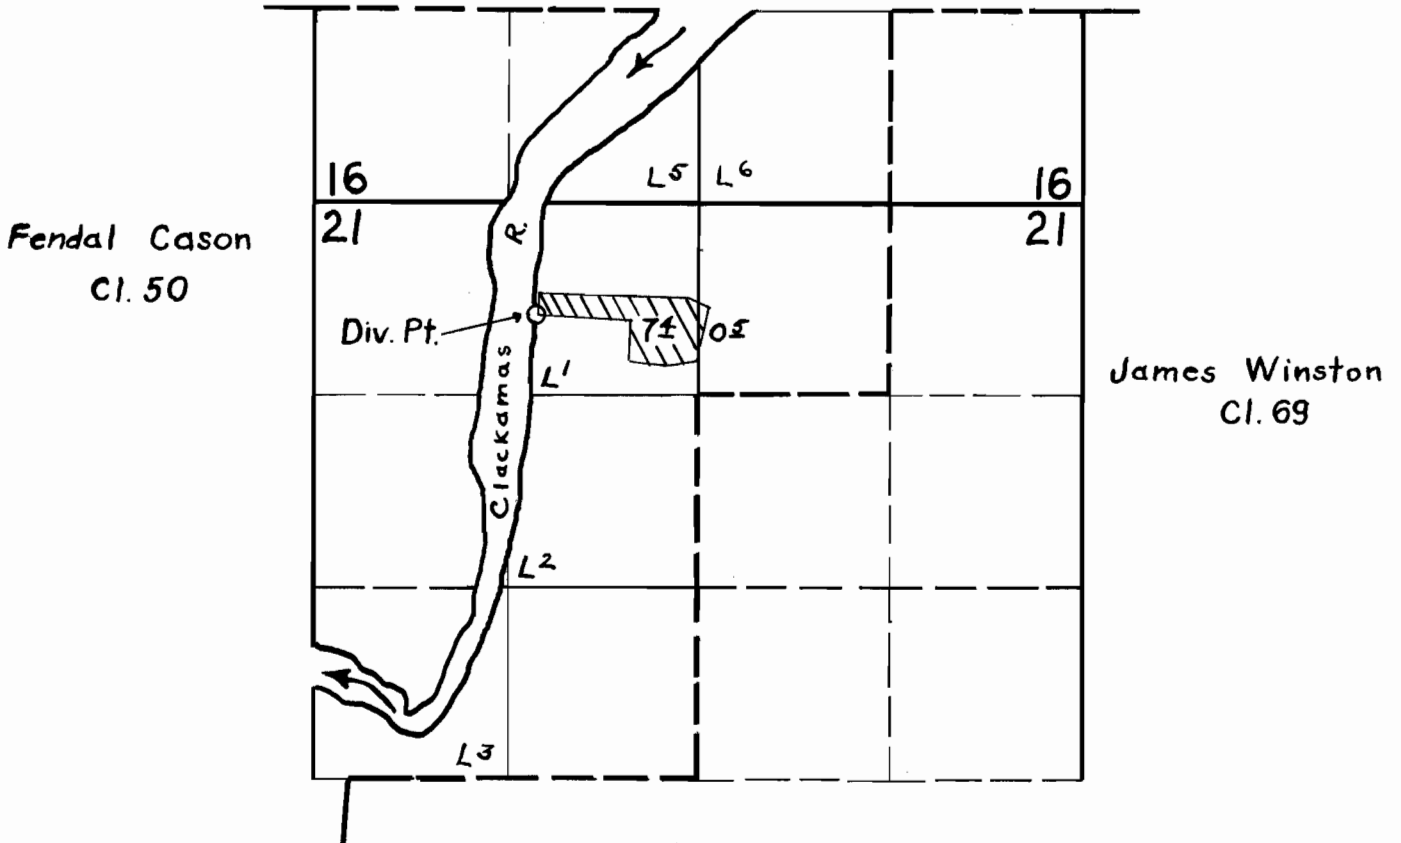

**FINAL PROOF SURVEY**

UNDER

Application No. 28234 Permit No. 22208

IN NAME OF

**JOHN N. HAYES**

Surveyed 6 Sept. 1955, by C. Cummings