


T. 3 S., R. 2 & 3 W. W.M.

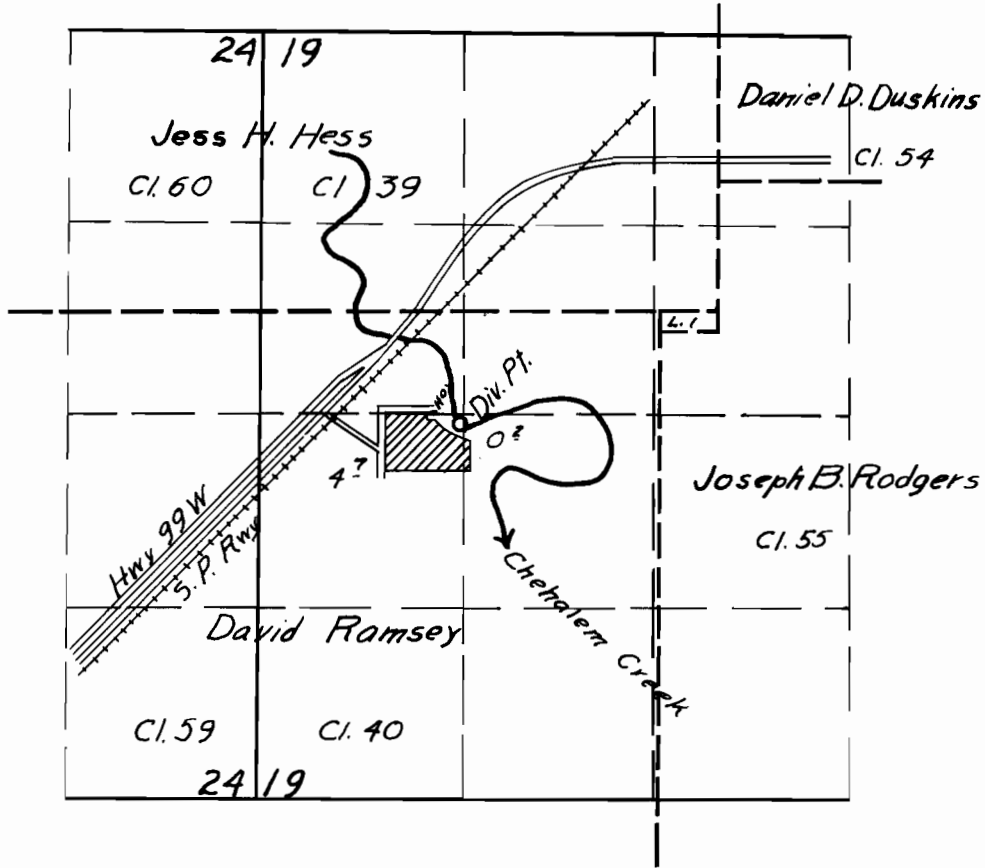

FINAL PROOF SURVEY

UNDER

Application No. **28322** Permit No. **22357**

IN NAME OF

ROBERT ZARD

Surveyed **30 Sept 1955**, by *Robert Zard*