


T1S R9WWM

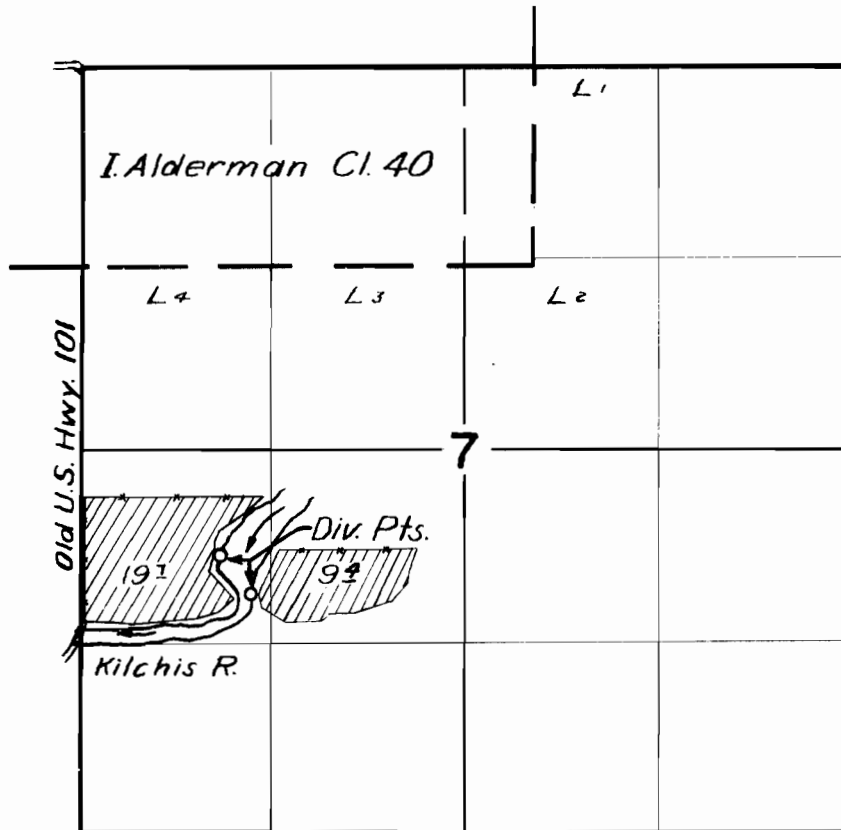

FINAL PROOF SURVEY

UNDER

Application No. 28505 Permit No. 22501

IN NAME OF

Martha Pigman

Surveyed July 7, 1955, by M. Bish

1955L