


T. 7 S. R. 1 W. W. M.

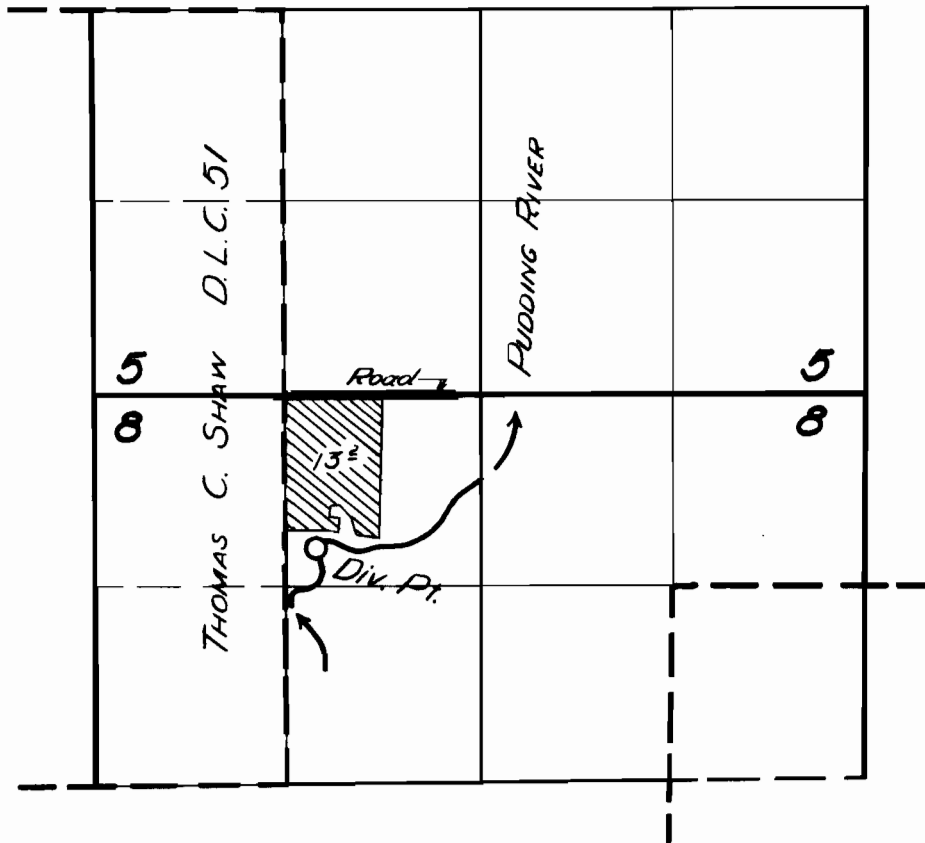

FINAL PROOF SURVEY

UNDER

Application No. 21702 Permit No. 17042

IN NAME OF

HARVEY LINCOLN

Surveyed 16 May 1955, by T. JONES

1955-Z