


T. 4S. R. 2E. WM

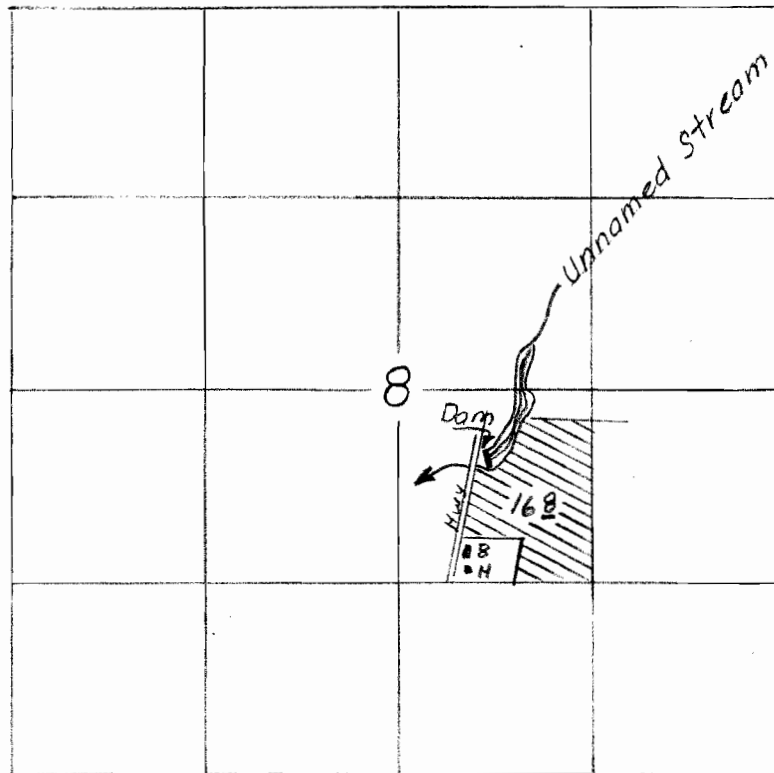

FINAL PROOF SURVEY
Under

Application 21782 Permit 17136
IN NAME OF

Lee A. Schlabach

Surveyed May 21, 1953 by H.L. Coffman