


T IN. RIO W.W.M.

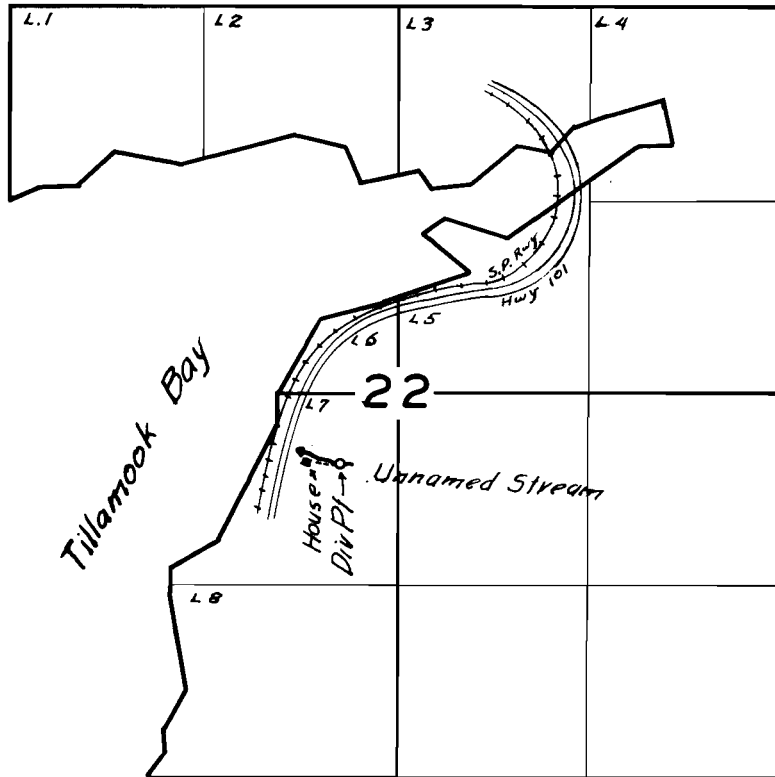

FINAL PROOF SURVEY

UNDER

Application No. 21809. Permit No. 17161.
IN NAME OF

L. F. ~~Bennett~~

Surveyed 21 July 1955, by *Robert A. Reed*