


T.2S.,R.44&45E.W.M.

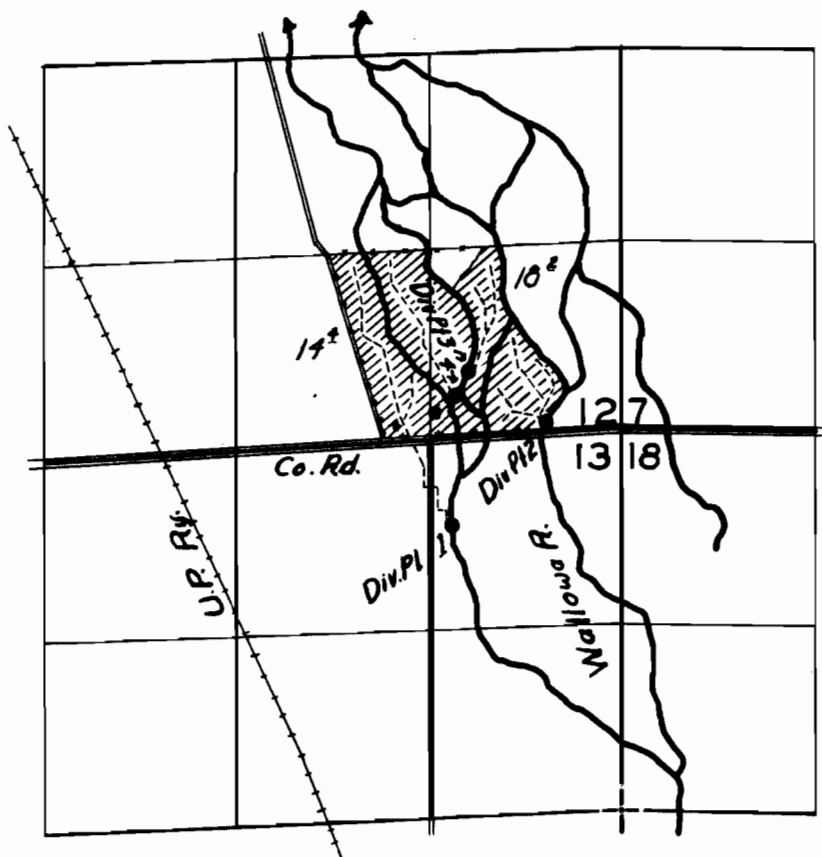

FINAL PROOF SURVEY

UNDER

Application No. 21868 Permit No. 17199

IN NAME OF

RALPH MAKIN

Surveyed 11 August 1955, by Robert H. Reed