


T. 3 S. R. 10 W. W. M.

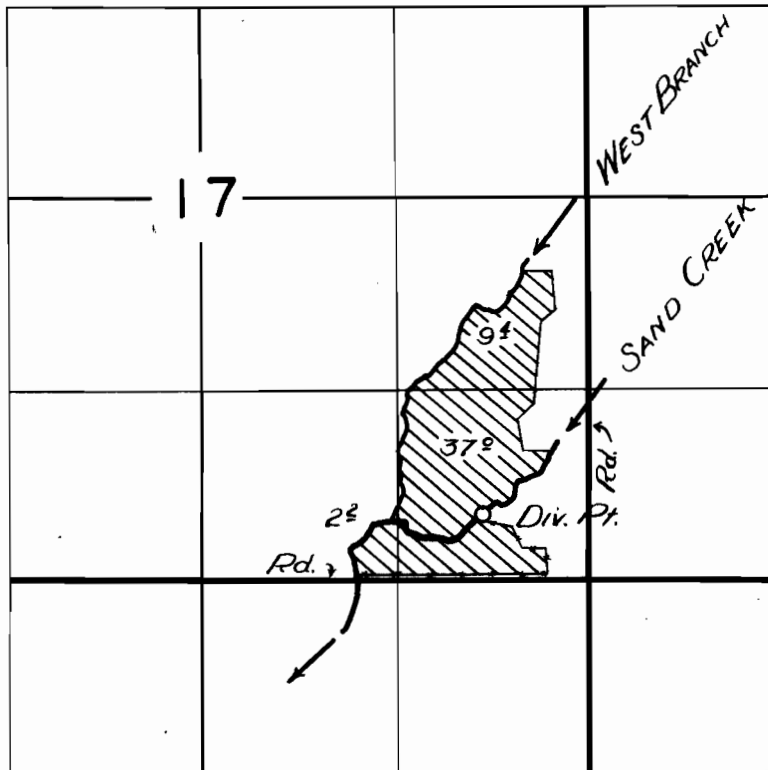

FINAL PROOF SURVEY

UNDER

Application No. 22049 Permit No. 17404

IN NAME OF

ARCHIE M. SCHENCK

Surveyed 15 Aug. 1955, by