


T. 2 S. R. 5 W. W.M.

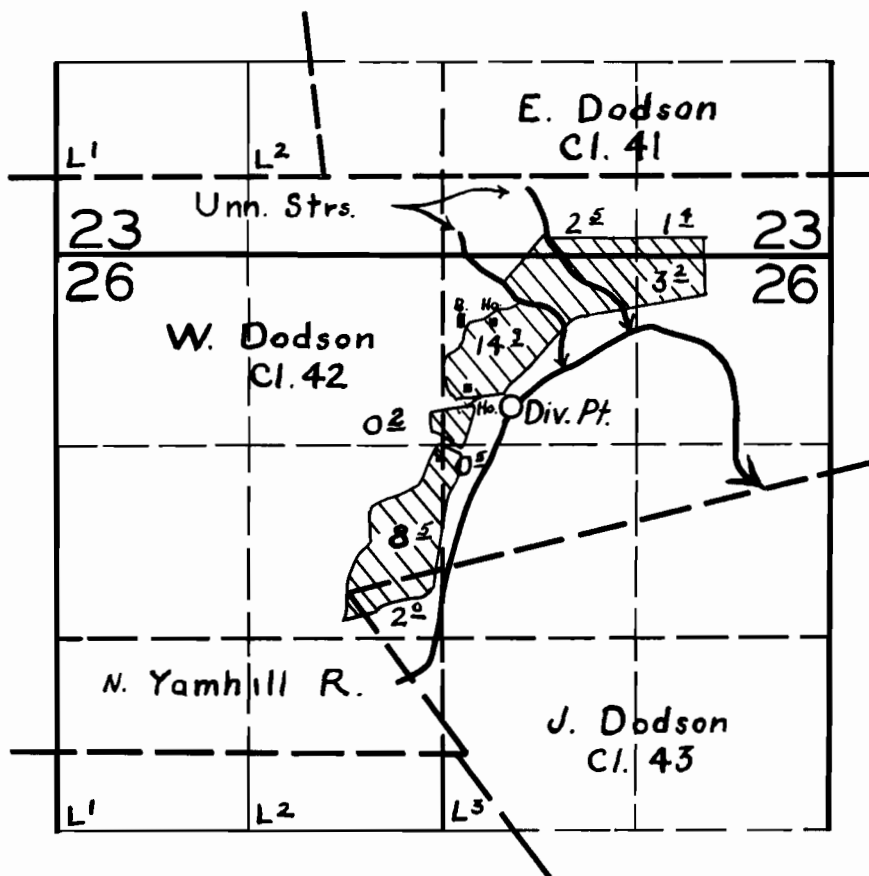

FINAL PROOF SURVEY
UNDER

Application No. **22226** Permit No. **17499**
IN NAME OF

CLIFFORD HACKER

Surveyed **2 May 1955**, by **H. Coffman**