


T28SR14WWM

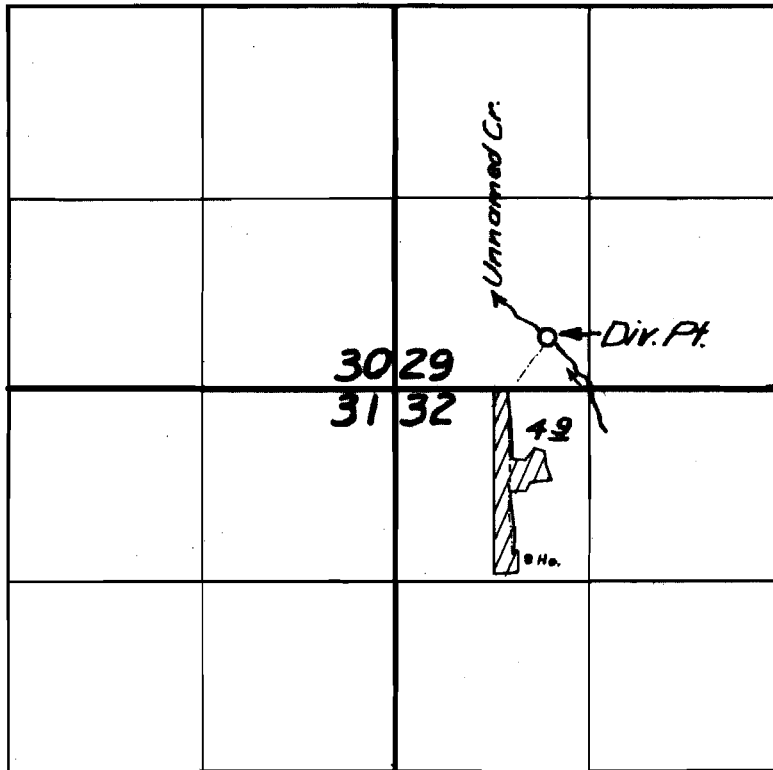

FINAL PROOF SURVEY

UNDER

Application No. 22415 Permit No. 17668

IN NAME OF

ROY B. MALLORY

Surveyed Aug 17, 1955, by M. Bush