


T. 28 S. R. 11 W. W.M.

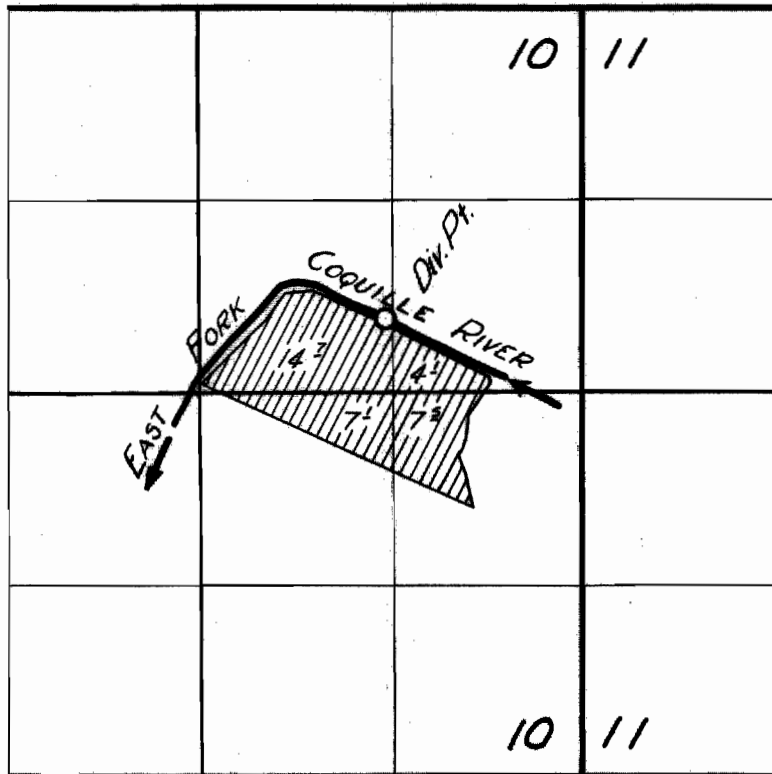

FINAL PROOF SURVEY

UNDER

Application No. 22618 Permit No. 17788

IN NAME OF

LAIRD BROS.

Surveyed 20 Mar. 1955, by T. JONES