


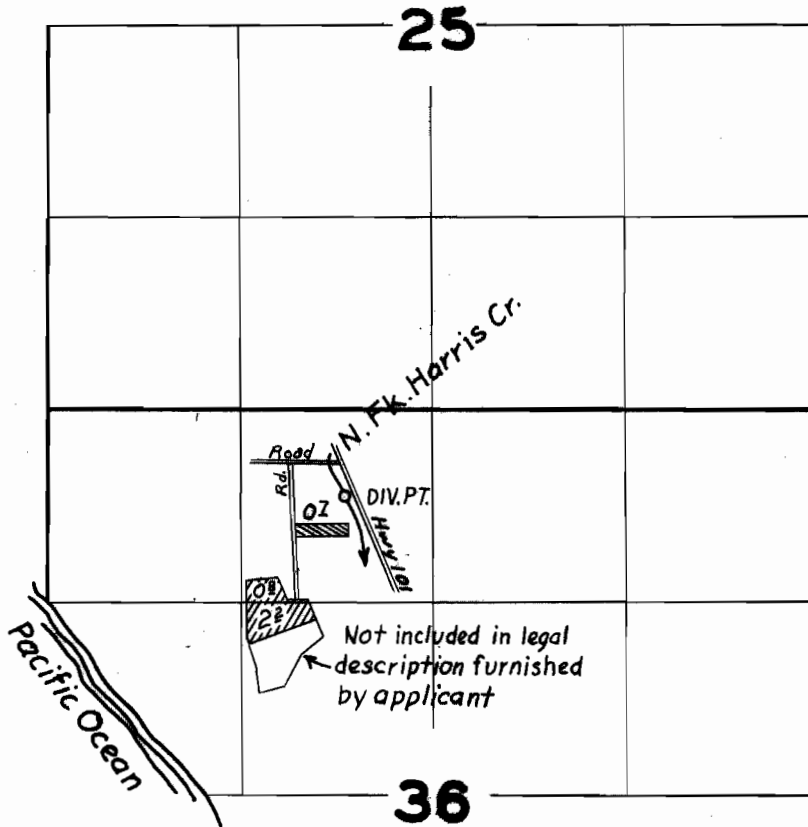

T.40S. R.14W WM



Permit 16416 
Permit 22710 

FINAL PROOF SURVEY

UNDER

Application No. 20970 Permit No. 16416
22710 17849

IN NAME OF

Lloyd H. Morris

Surveyed Sept 9, 1953, by T. Jones