


T27SR13WWM

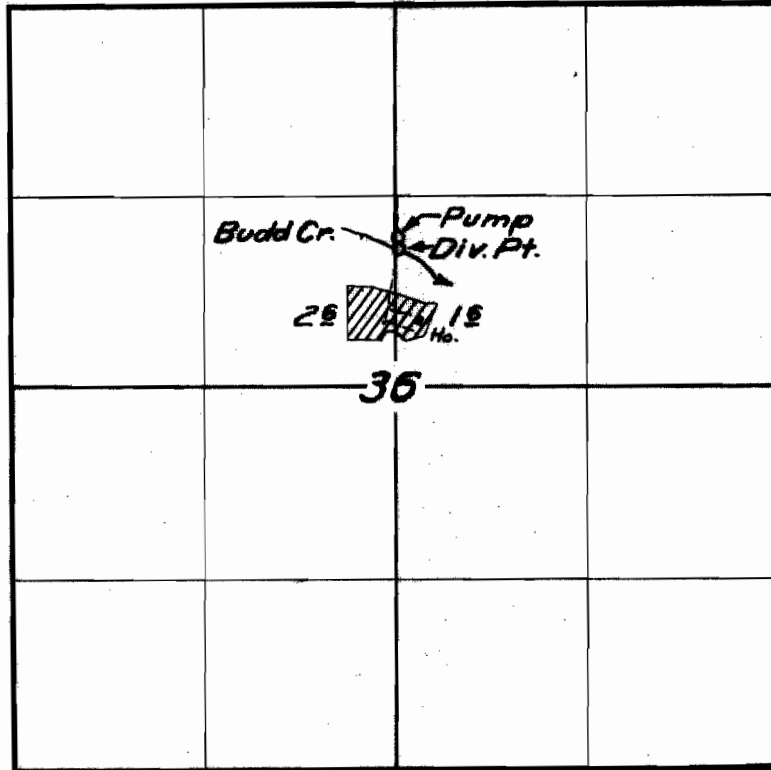

FINAL PROOF SURVEY

UNDER

Application No. 22635 Permit No. 17883

IN NAME OF

A. N. GOULD

Surveyed Aug. 2 1955, by M. Bish