


T. 2 S. R. 4 W. W. M.

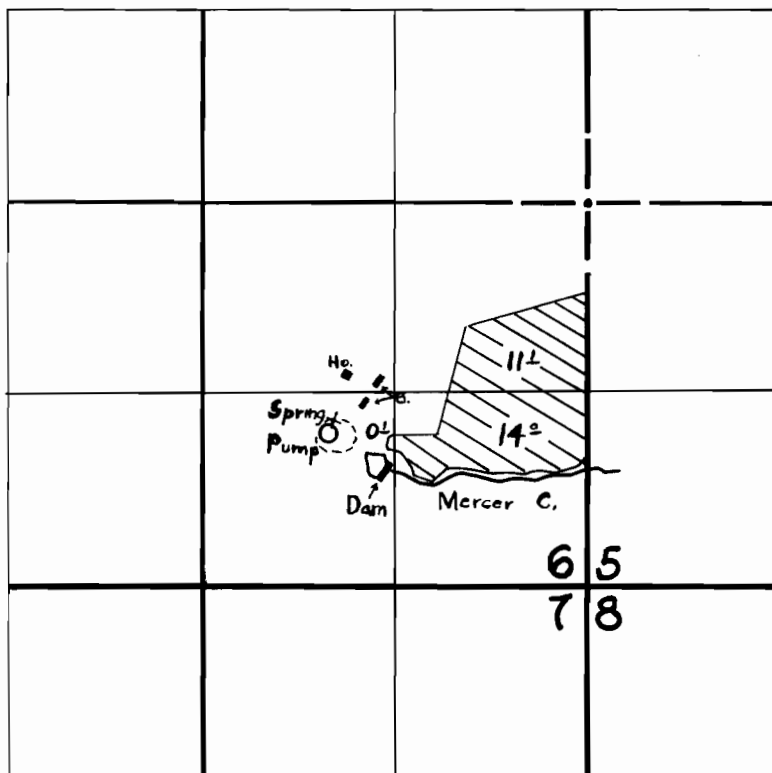

FINAL PROOF SURVEY

UNDER

Application No. 22622 Permit No. 17893

IN NAME OF

GLENN R. PHILLIPS

Surveyed 29 Apr. 1955, by H. Coffman