


T29S R12 WWM

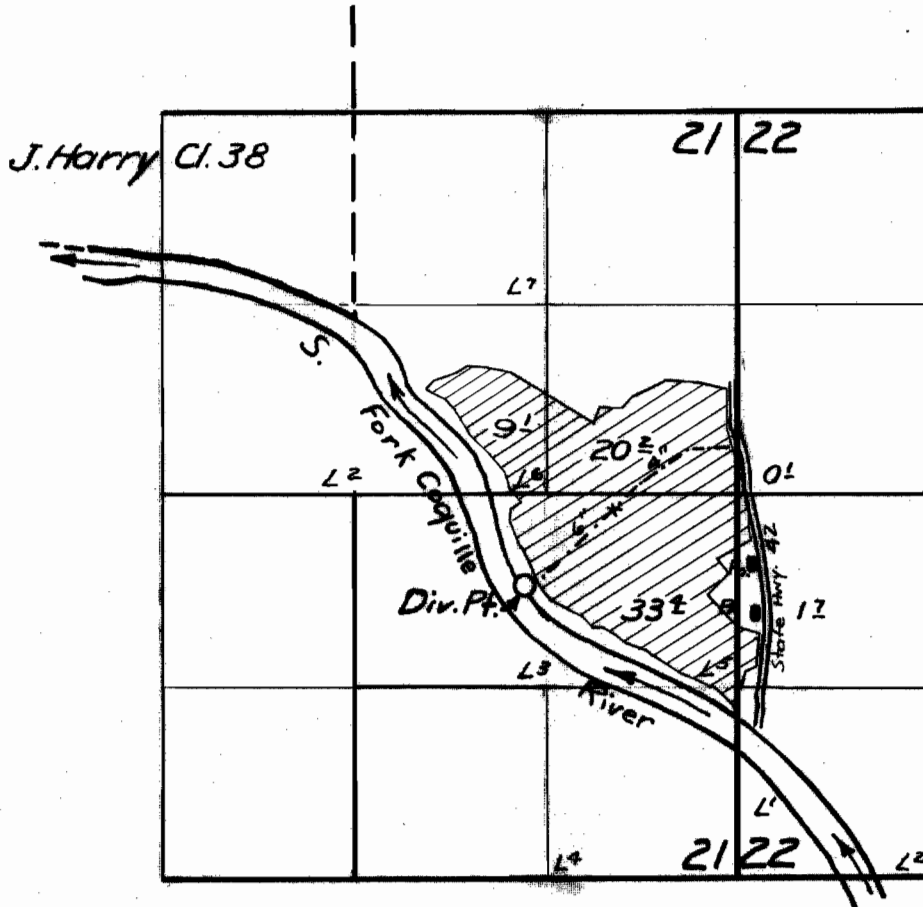

**FINAL PROOF SURVEY**

UNDER

Application No. 22665 Permit No. 17974

IN NAME OF

ROSE GARRETT

Surveyed Aug 10 1955, by M. B. [Signature]