


T. I. S. R. 9 W. W. M.

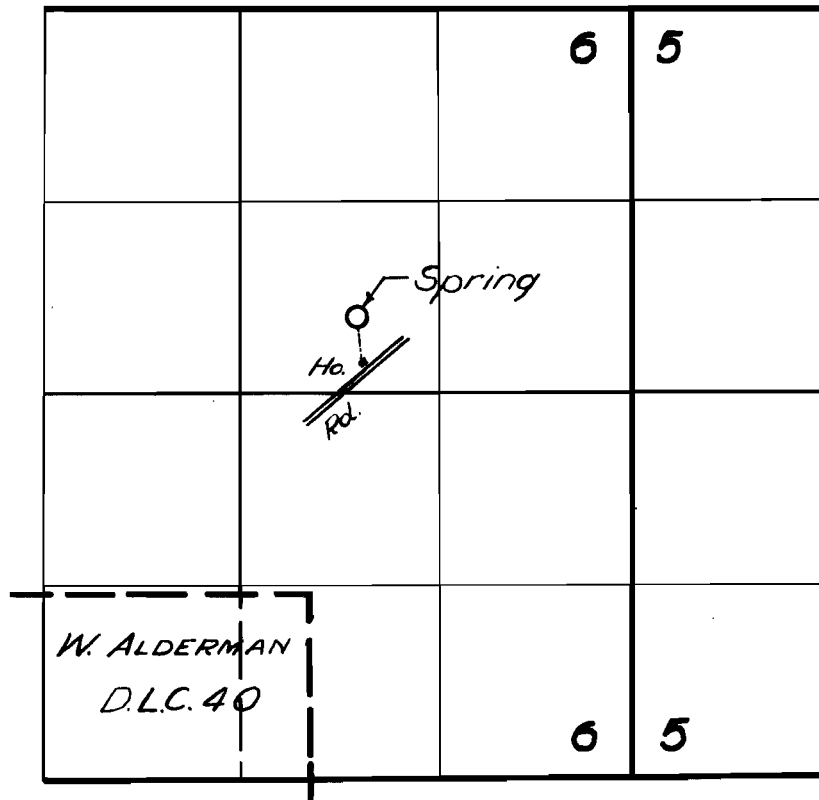

FINAL PROOF SURVEY

UNDER

Application No. 22942 Permit No. 18081

IN NAME OF

EDWIN C. LANDIS

Surveyed 7 July 1955, by T. JONES

1955-Z