


T. 30S, R. 14 & 15 W.W.M.

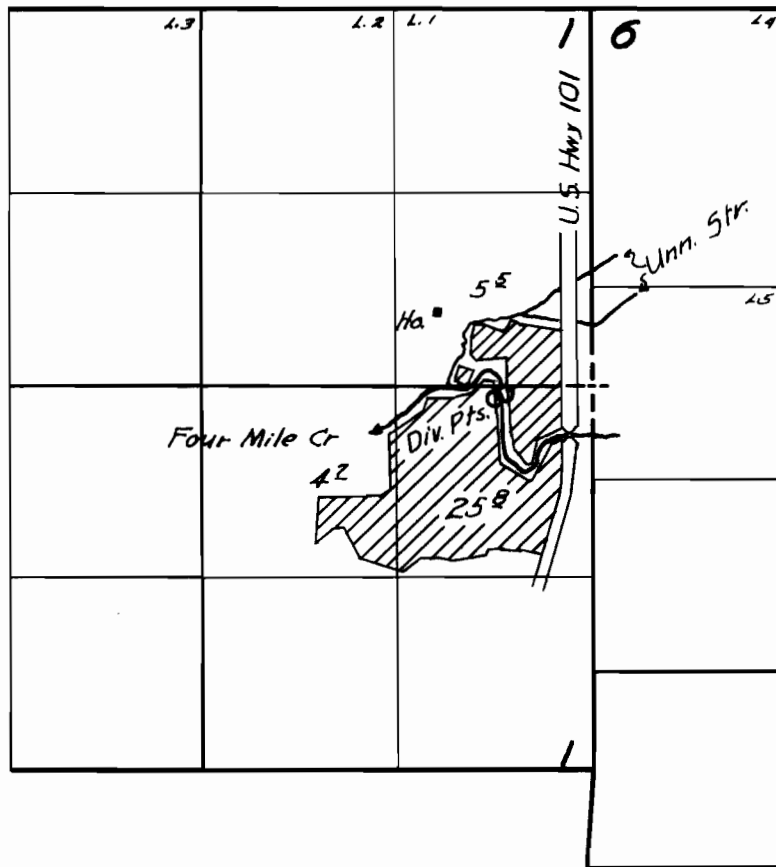

FINAL PROOF SURVEY
UNDER

Application No. 22988 Permit No. 18098
IN NAME OF

ELSIE & EDWARD R. RAUSCHERT

Surveyed 9 March 1955, by H. L. Coffman.