


T2S R9WWM

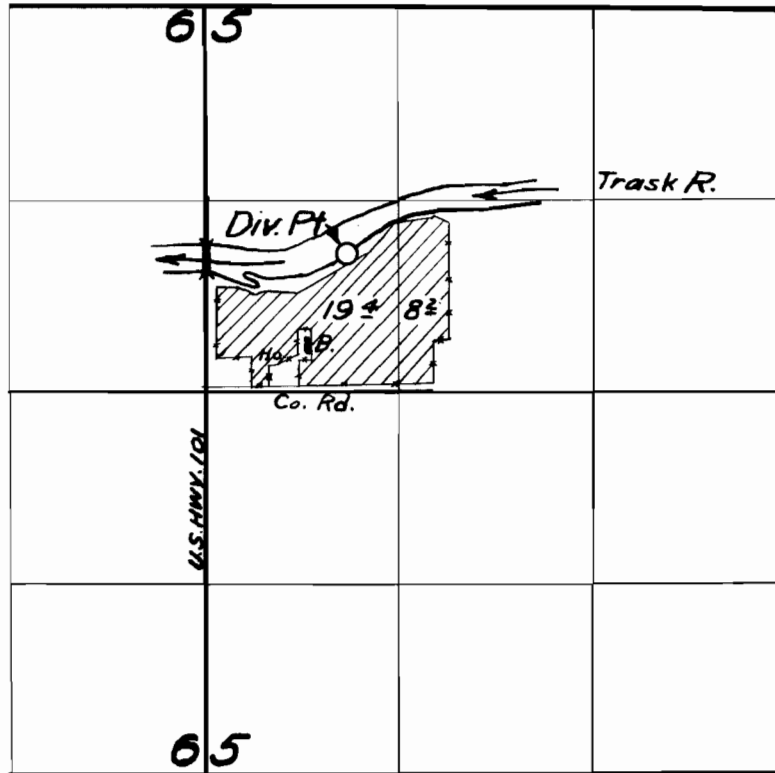

FINAL PROOF SURVEY

UNDER

Application No. 22848 Permit No. 18108

IN NAME OF

ORVAL KASER

Surveyed July 27 1955 by m. Bish