


T.3S.R.9W.W.M.

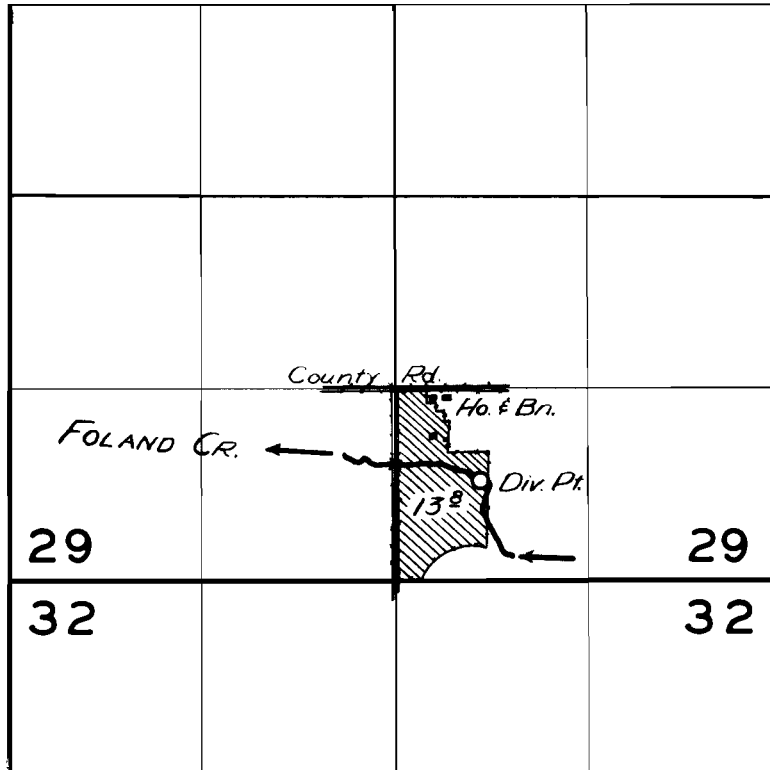

FINAL PROOF SURVEY

UNDER

Application No. 23029. Permit No. 18147

IN NAME OF

JOHN V. DOSTAL

Surveyed 26, Aug. 1955, by *R. Whitby*