


T.2 S.R.9 W.W.M.

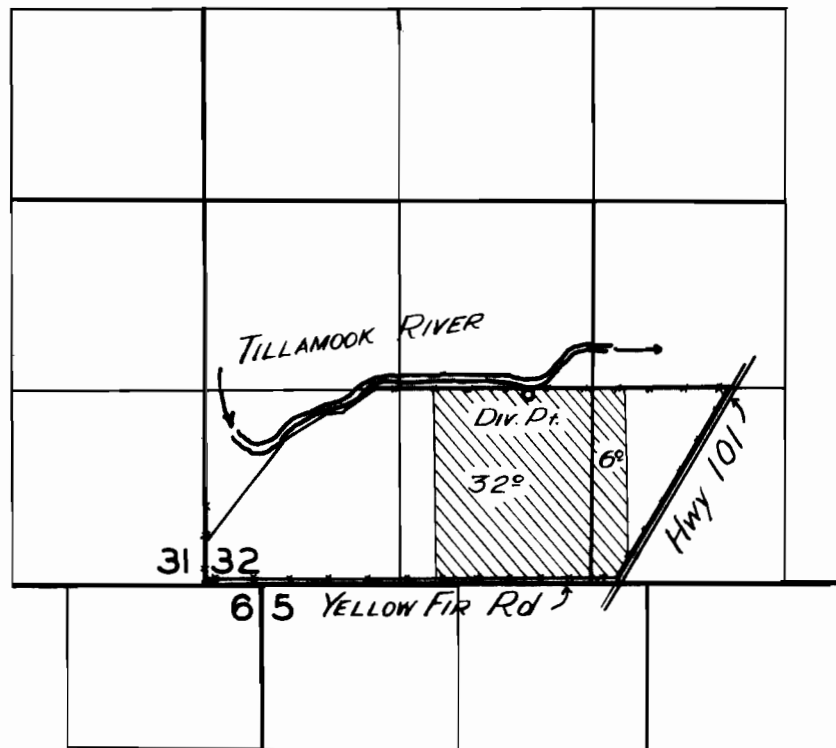

FINAL PROOF SURVEY
UNDER

Application No. 23119 Permit No. 18222
IN NAME OF

CASPER ROBITSCH

Surveyed 8 Aug 1955, by *E. D. Whitley*

1955-E