


T1&2S.R.45E.W.M.

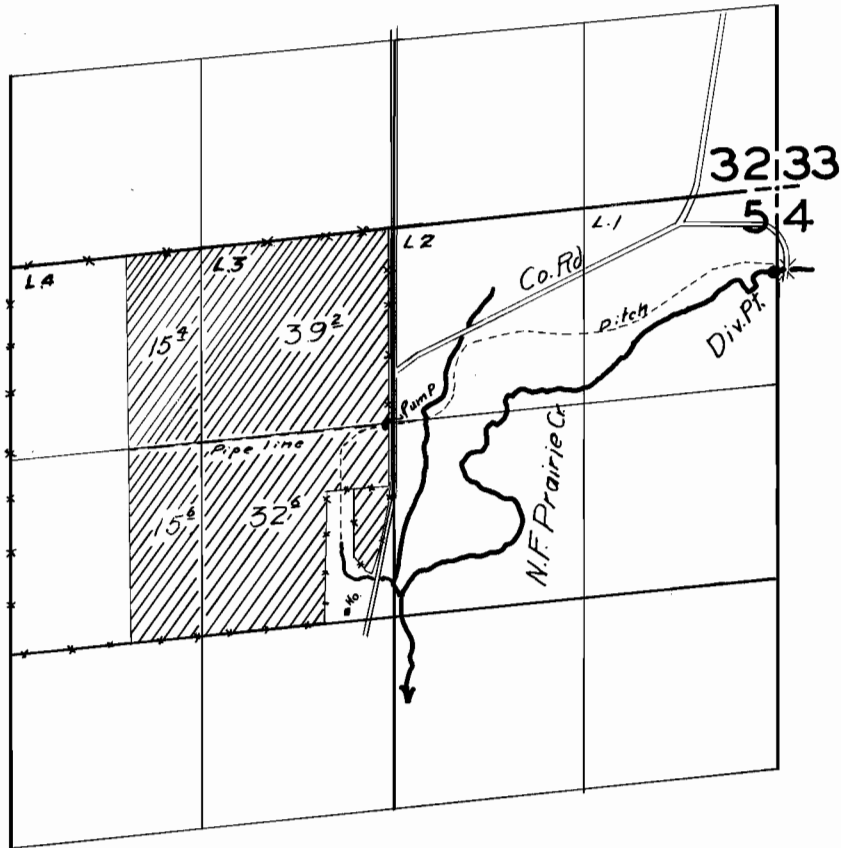

FINAL PROOF SURVEY
UNDER

Application No. 23186. Permit No. 18255
IN NAME OF

LYNN WARD

Surveyed 11 August, 1955, by *Robert H. Reed*