


T. 11 S. R. 22E. W.M.

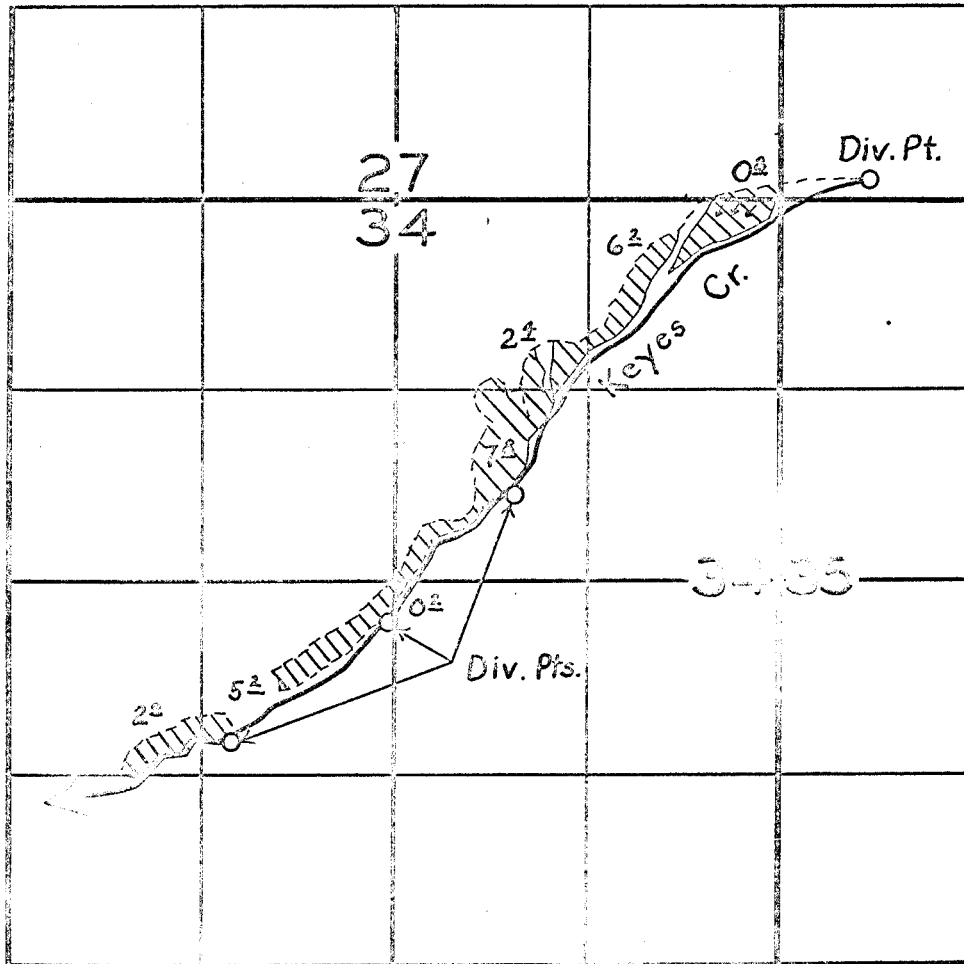

FINAL PROOF SURVEY
UNDER

Application No. 23162... Permit No. 1-283....

IN NAME OF

ISAAC BLANN

Surveyed 20 Apr. 1955, by T. Jones.....

DOV-10H-204

Per