


T. 1 N., R. 10 W. W.M.

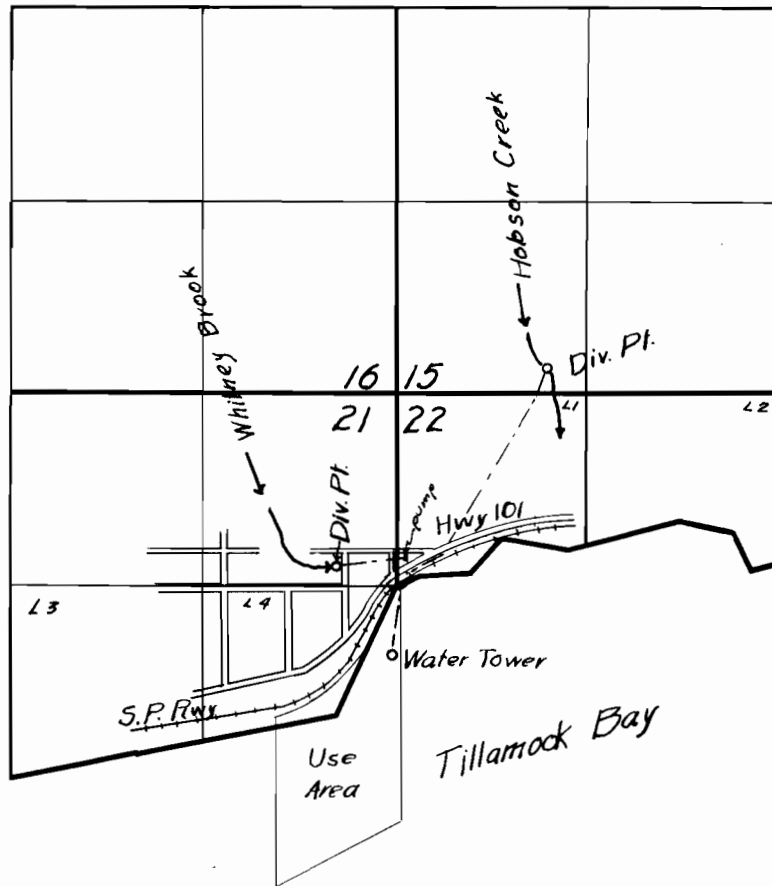

FINAL PROOF SURVEY

UNDER

Application No. 21295 23329 Permit No. 16698 18313

IN NAME OF

POWER & LIGHT COMPANY

Surveyed 28 July 1955, by Robert H. [Signature]