


T. 10 S. R. 10 W. W.M.

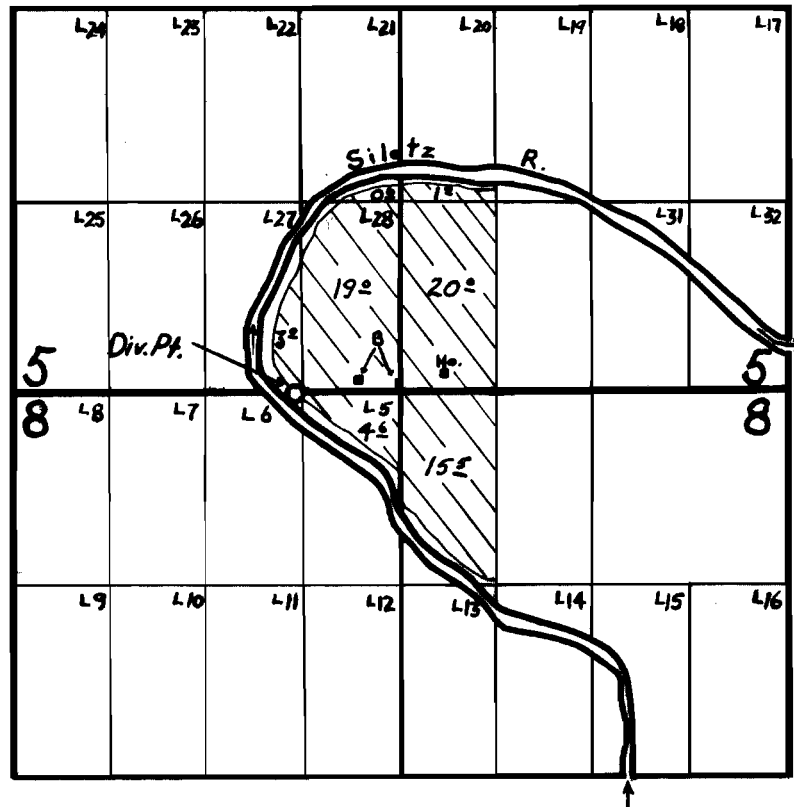

FINAL PROOF SURVEY
UNDER

Application No. 23305 Permit No. 18379
IN NAME OF

EVA L. KAUFFMAN

Surveyed 21 Apr. 1955, by H. Coffman