


T. 4 S. R. 4 W. W.M.

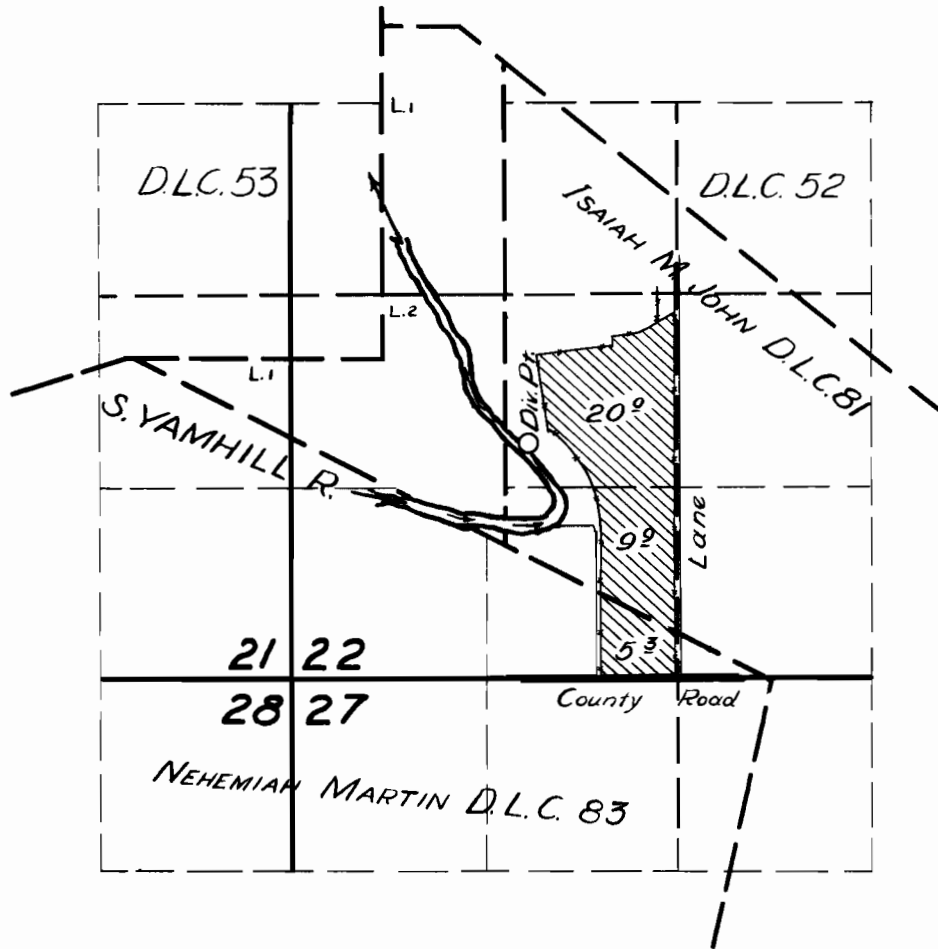

FINAL PROOF SURVEY

UNDER

Application No. 23386 Permit No. 18461

IN NAME OF

LAWRENCE SOHRWEID

Surveyed 21 Sep. 1955, by *P. H. Wilby*

DFQ-3D-141