


T285R12WWM

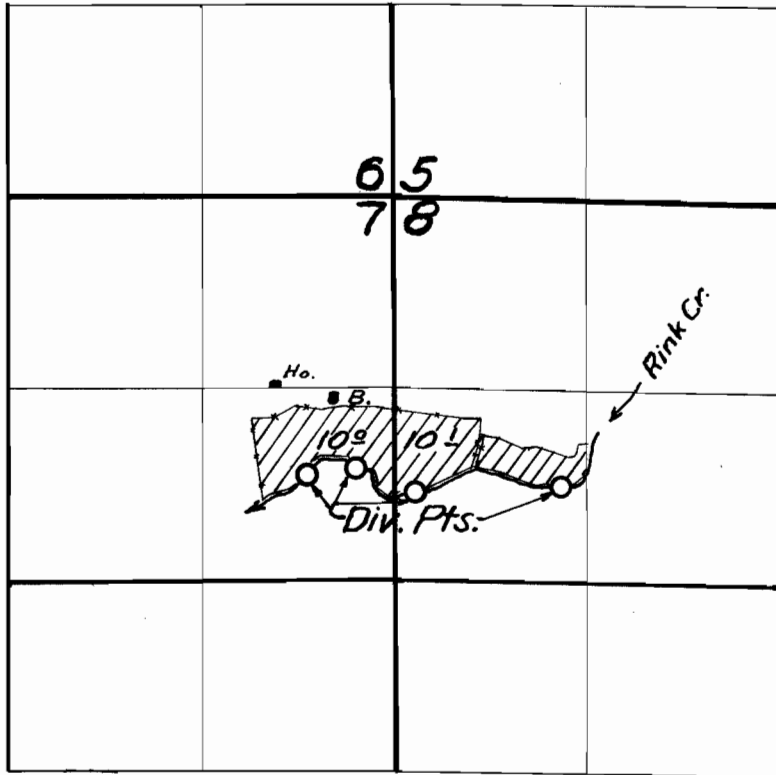

FINAL PROOF SURVEY

UNDER

Application No. 23392 Permit No. 18466

IN NAME OF

D.W. FISH

Surveyed Aug 6 1955, by Tr. Rich