


T. 3 S., R. 2 W. W. M.

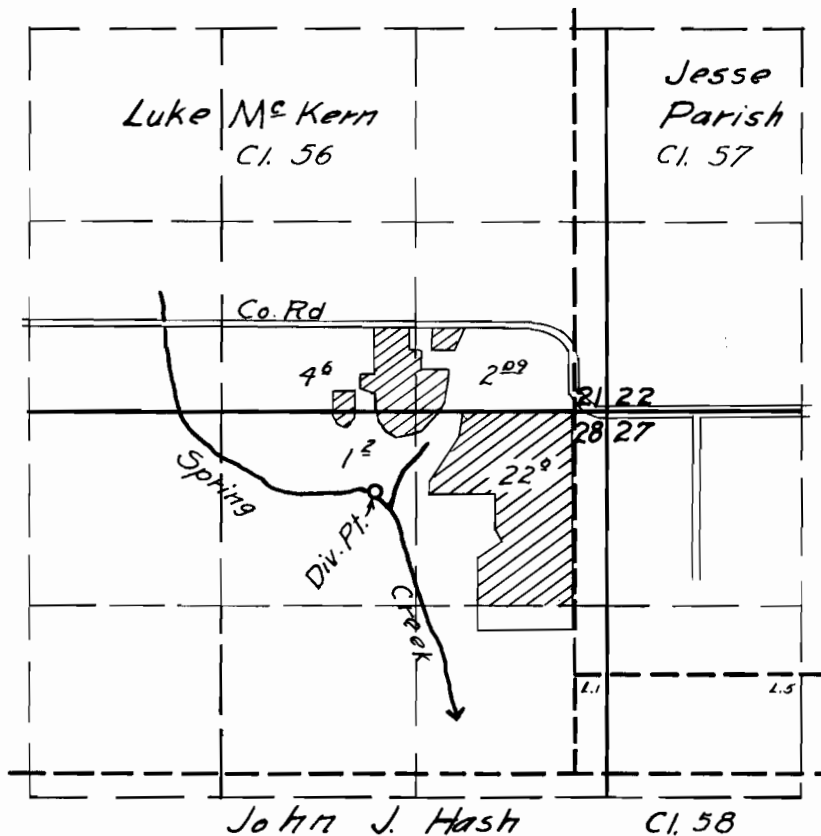

FINAL PROOF SURVEY
UNDER

Application No. 23444 Permit No. 18504
IN NAME OF

Estate of CLIFFORD W. JONES

Surveyed 22 Sept. 1955, by *Robert [Signature]*