


T. 2 S., R. 45 E., W. M.

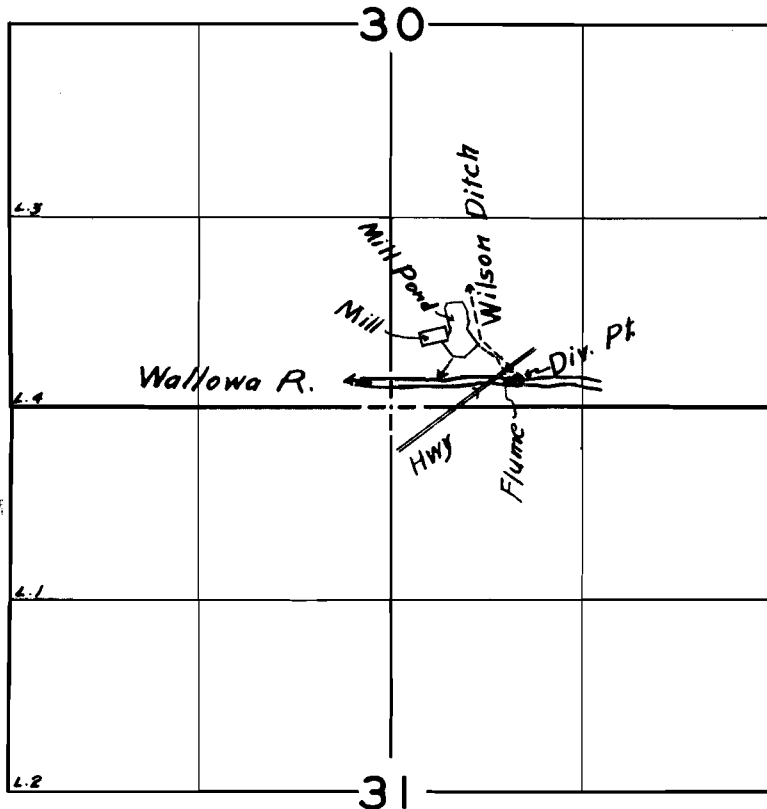

FINAL PROOF SURVEY

UNDER

Application No. 22450 Permit No. 18550

IN NAME OF

M. M. MILLER

Surveyed 15 Oct. 1953, by H. L. Coffman.

10 Aug. 1955 by Robert H. Burt