


T. 21 S., R. 46 & 47 E. W.M.

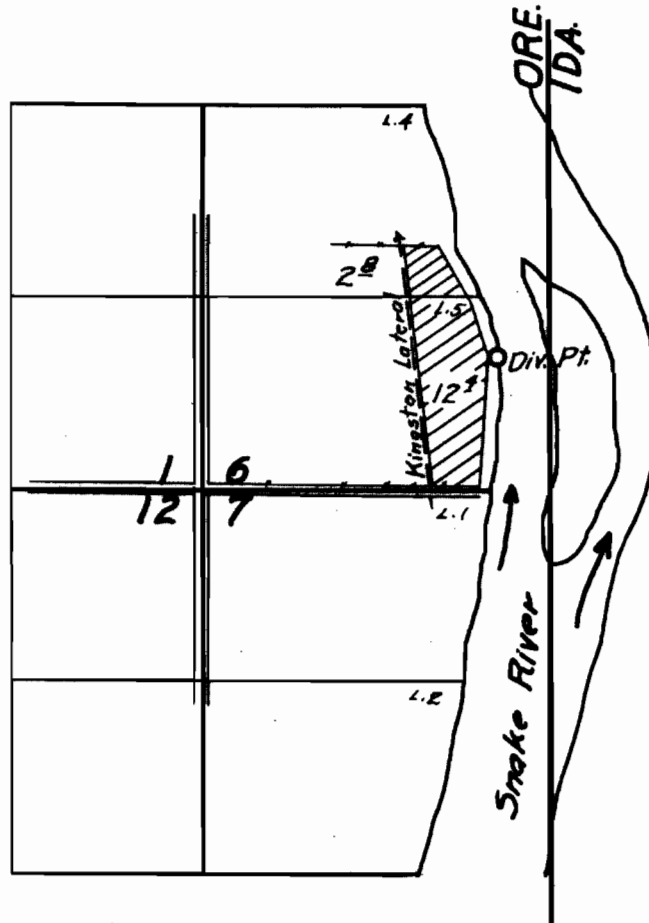

FINAL PROOF SURVEY
UNDER

Application No. *23549* Permit No. *18595*
IN NAME OF

C. M. BEAUMONT

Surveyed *2 April* 1955, by *H. L. Coffman*