


T. 14S. R. 14E. W.M.

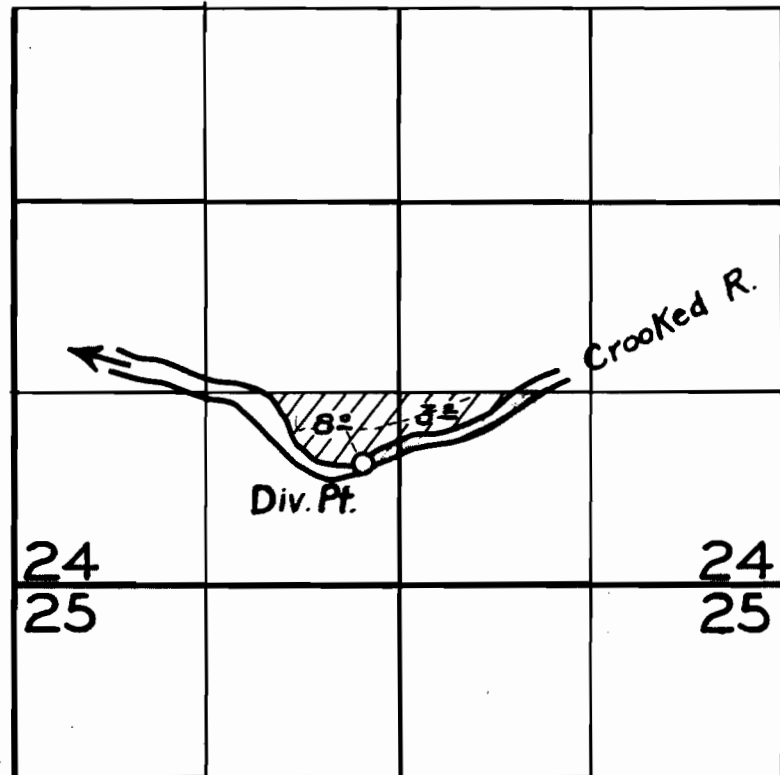

FINAL PROOF SURVEY
UNDER

Application No. 23556 Permit No. 18598

IN NAME OF

MAX MONTGOMERY

Surveyed 23 Apr. 1955, by T. Jones

DCY-3H-40

Handwritten mark