


Application No. 23629  
Permit No. 18629

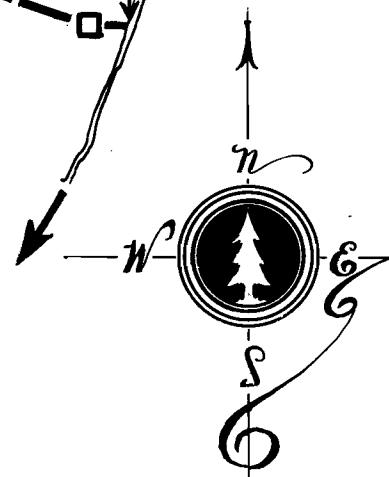

*Survey of Water System*  
For:  
**BANDON GUARD STATION**  
SECTION 1 T. 30 S. R. 15 W. W. M.  
SCALE 1" = 50'  
DECLINATION 22°30'  
SURVEY BY: A.G. - J.C. - A.B. - A.B. JR. - L.W.A. JANUARY 14, 1949  
DRAWN: LWA - H.H. 2-49