


T. 15 S. R. 14 E. W.M.

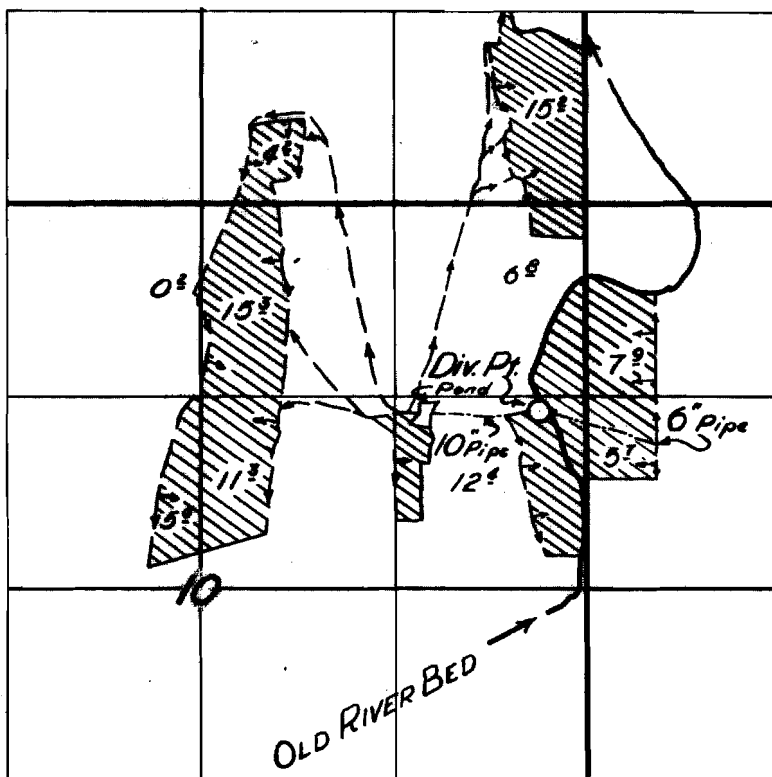

FINAL PROOF SURVEY

UNDER

Application No. 21332 Permit No. 18675

IN NAME OF

ELDON F., EUGENE D. & WANDA L. HARGIS

Surveyed 10 May 1955, by T. JONES

1955-Z