


T. 35, R. 2 W. W. M.

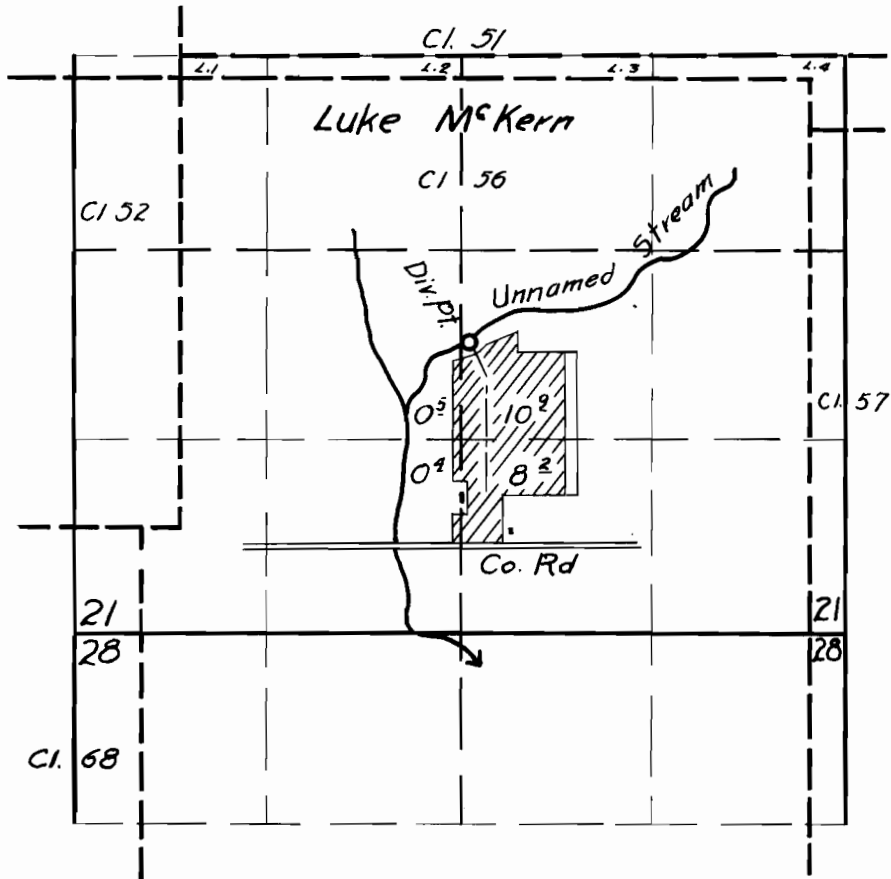

FINAL PROOF SURVEY  
UNDER

Application No. 23425 Permit No. 18800  
IN NAME OF

L. W. MOSER

Surveyed 28 Sept. 1955, by *Robert H. [Signature]*