


P. 18882
21690

T.13 S.R. 26 EWM

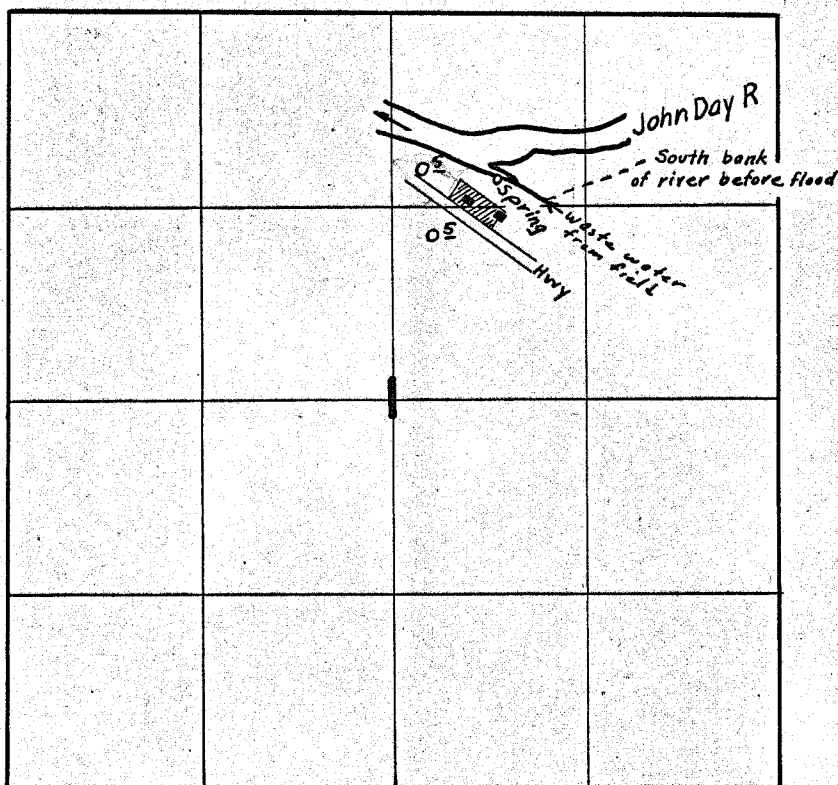

FINAL PROOF SURVEY

UNDER

Application No. 23792.... Permit No. 18882....

IN NAME OF

.....Arthur C. Martin.....

Surveyed ..Aug...31 1954... by ..H. L. Coffman..

1954-A