


MAP

To Accompany Application for a Permit
To Appropriate Water
School District #36 Coos County ORE
Sec 34, Twp 25 S. R. 12. W.

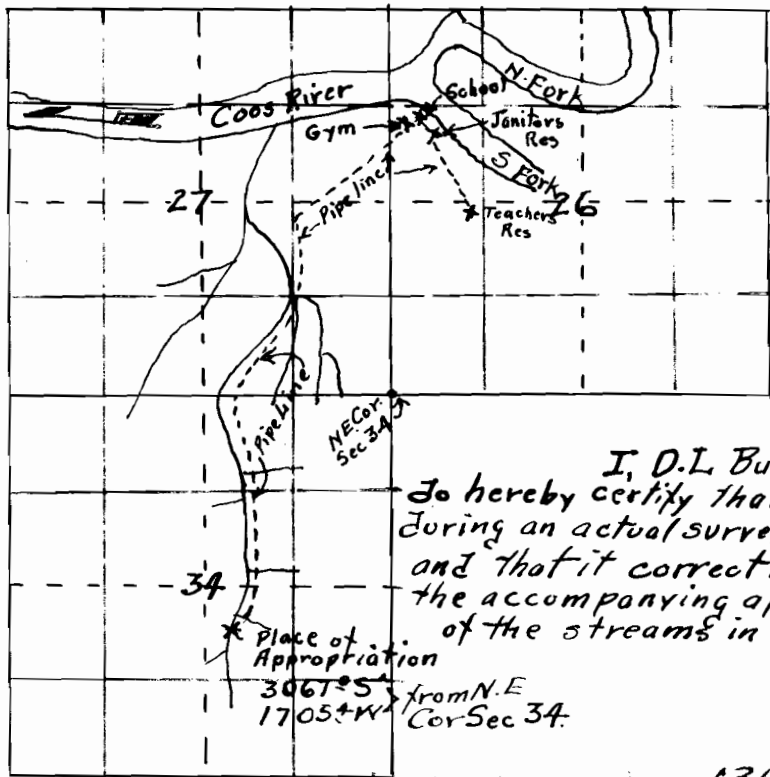

Scale
one inch = 1/2 mile

I, D. L. Buckingham, of Marshfield, Coos Co. Ore.
do hereby certify that this map was made from notes taken
during an actual survey made by me Sept. 17-18 and Oct 3 1929
and that it correctly represents the works described in
the accompanying application together with the location
of the streams in the immediate vicinity

I. D. L. Buckingham

13075
9319