


T. 30S, R. 46E W.W.

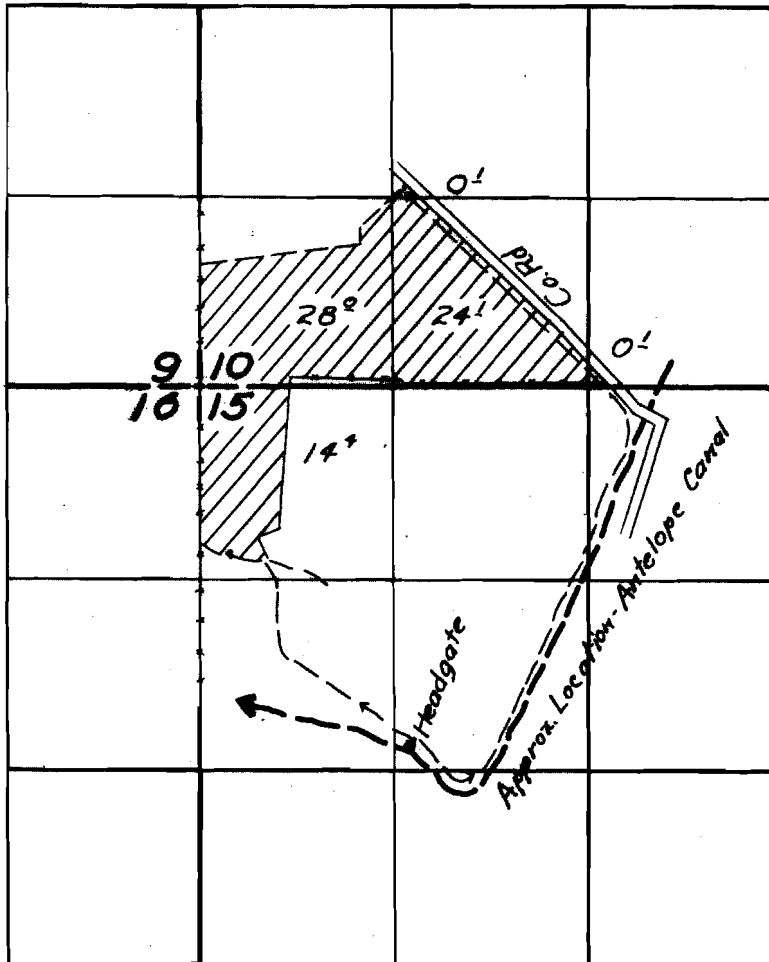

FINAL PROOF SURVEY

UNDER

Application No. 24351 Permit No. 19068

IN NAME OF

JACA BROTHERS

Surveyed 29 March 1955, by H. L. Coffman