


T. 29S., R. 15W.W.M.

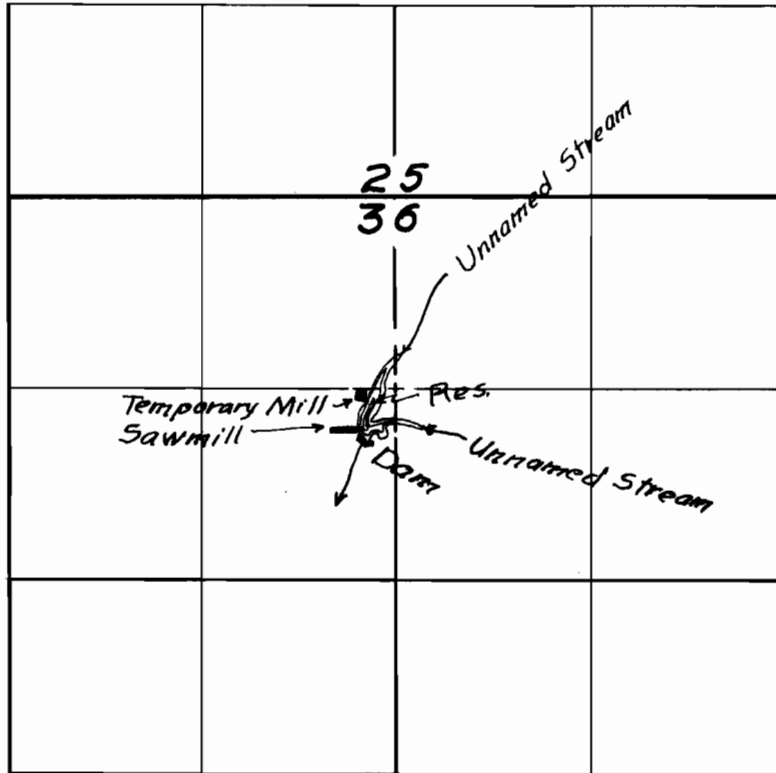

FINAL PROOF SURVEY

UNDER

R-22743

R-901

Application No. 22744 Permit No. 17932

IN NAME OF

MANFORD A. MARTIN

Surveyed 11 March 1955, by H.L. Coffman