



Range 26 E.W.M.

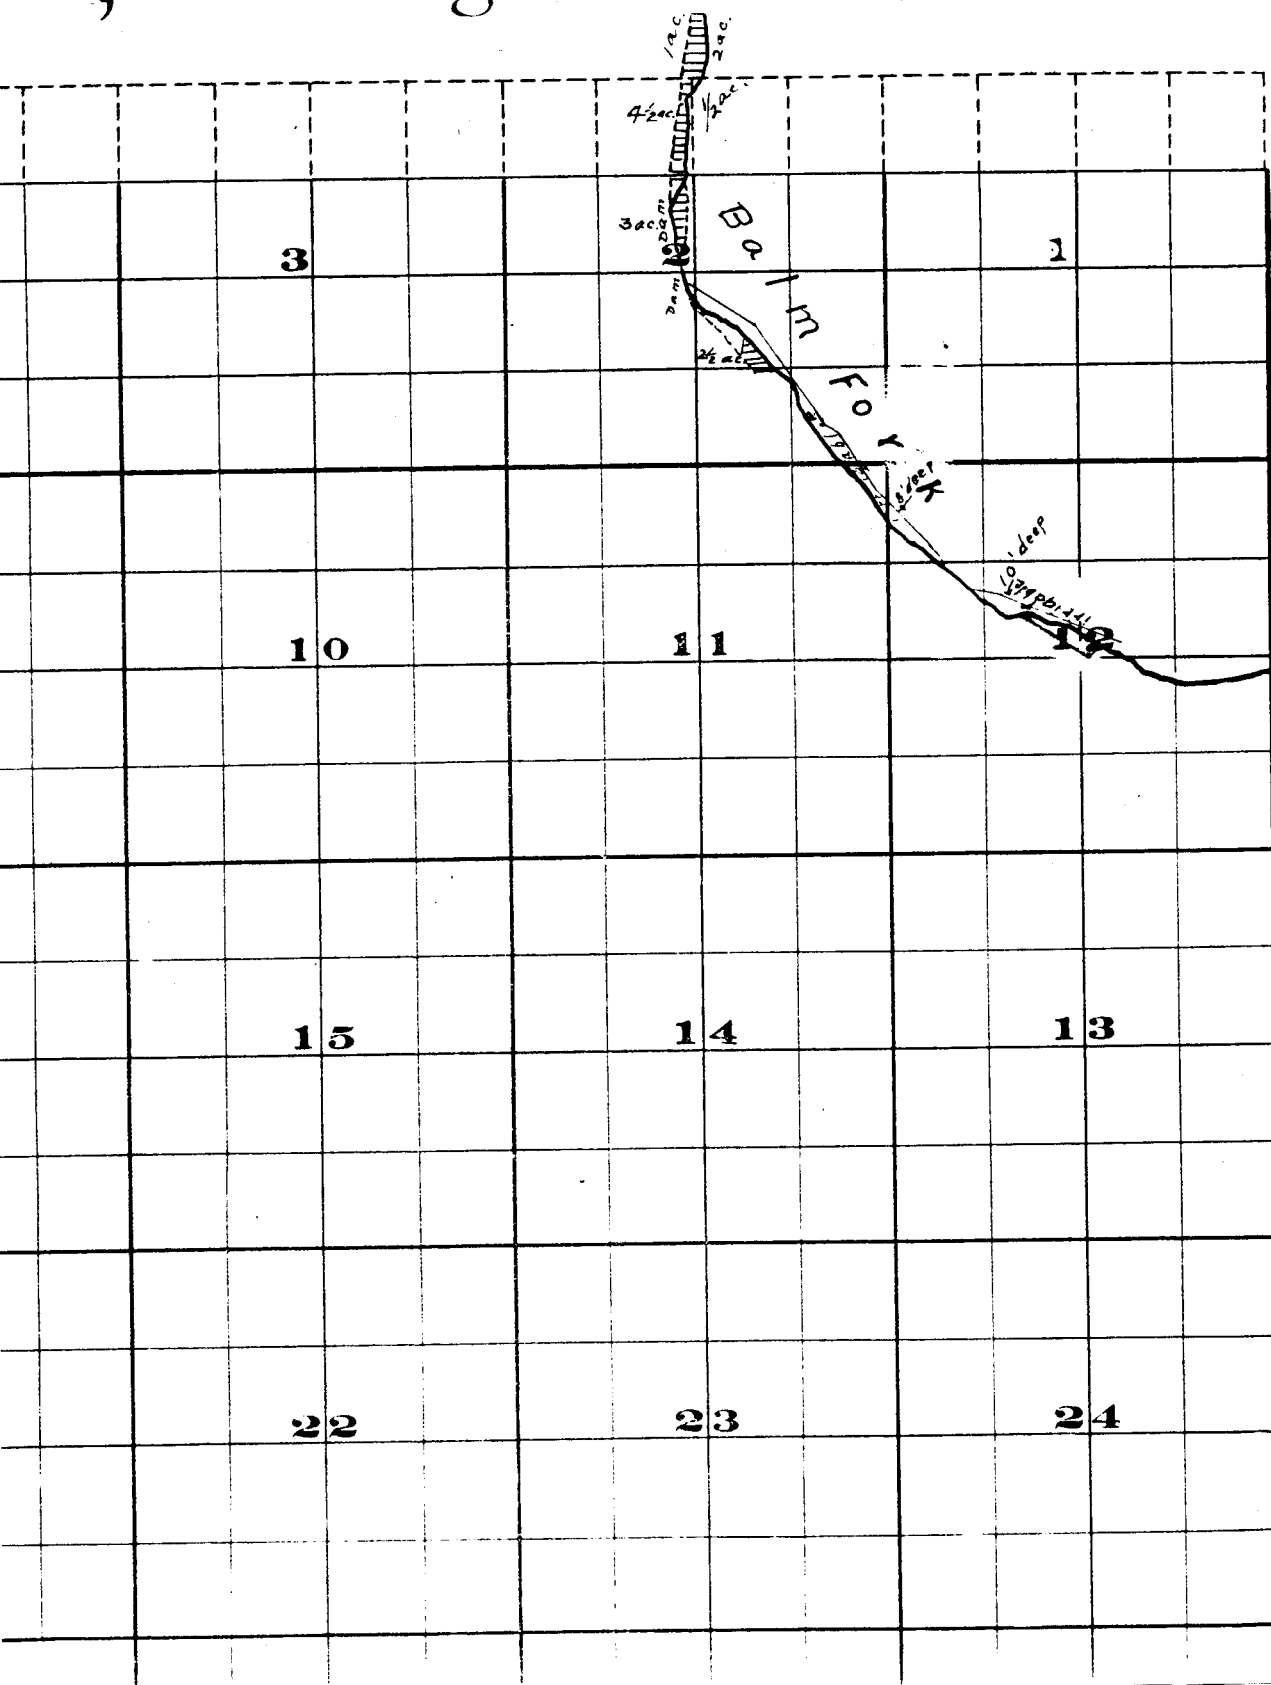

6			5			4			3
7			8			9			10
18			17			16			15
19			20			21			22
30			29			28			27

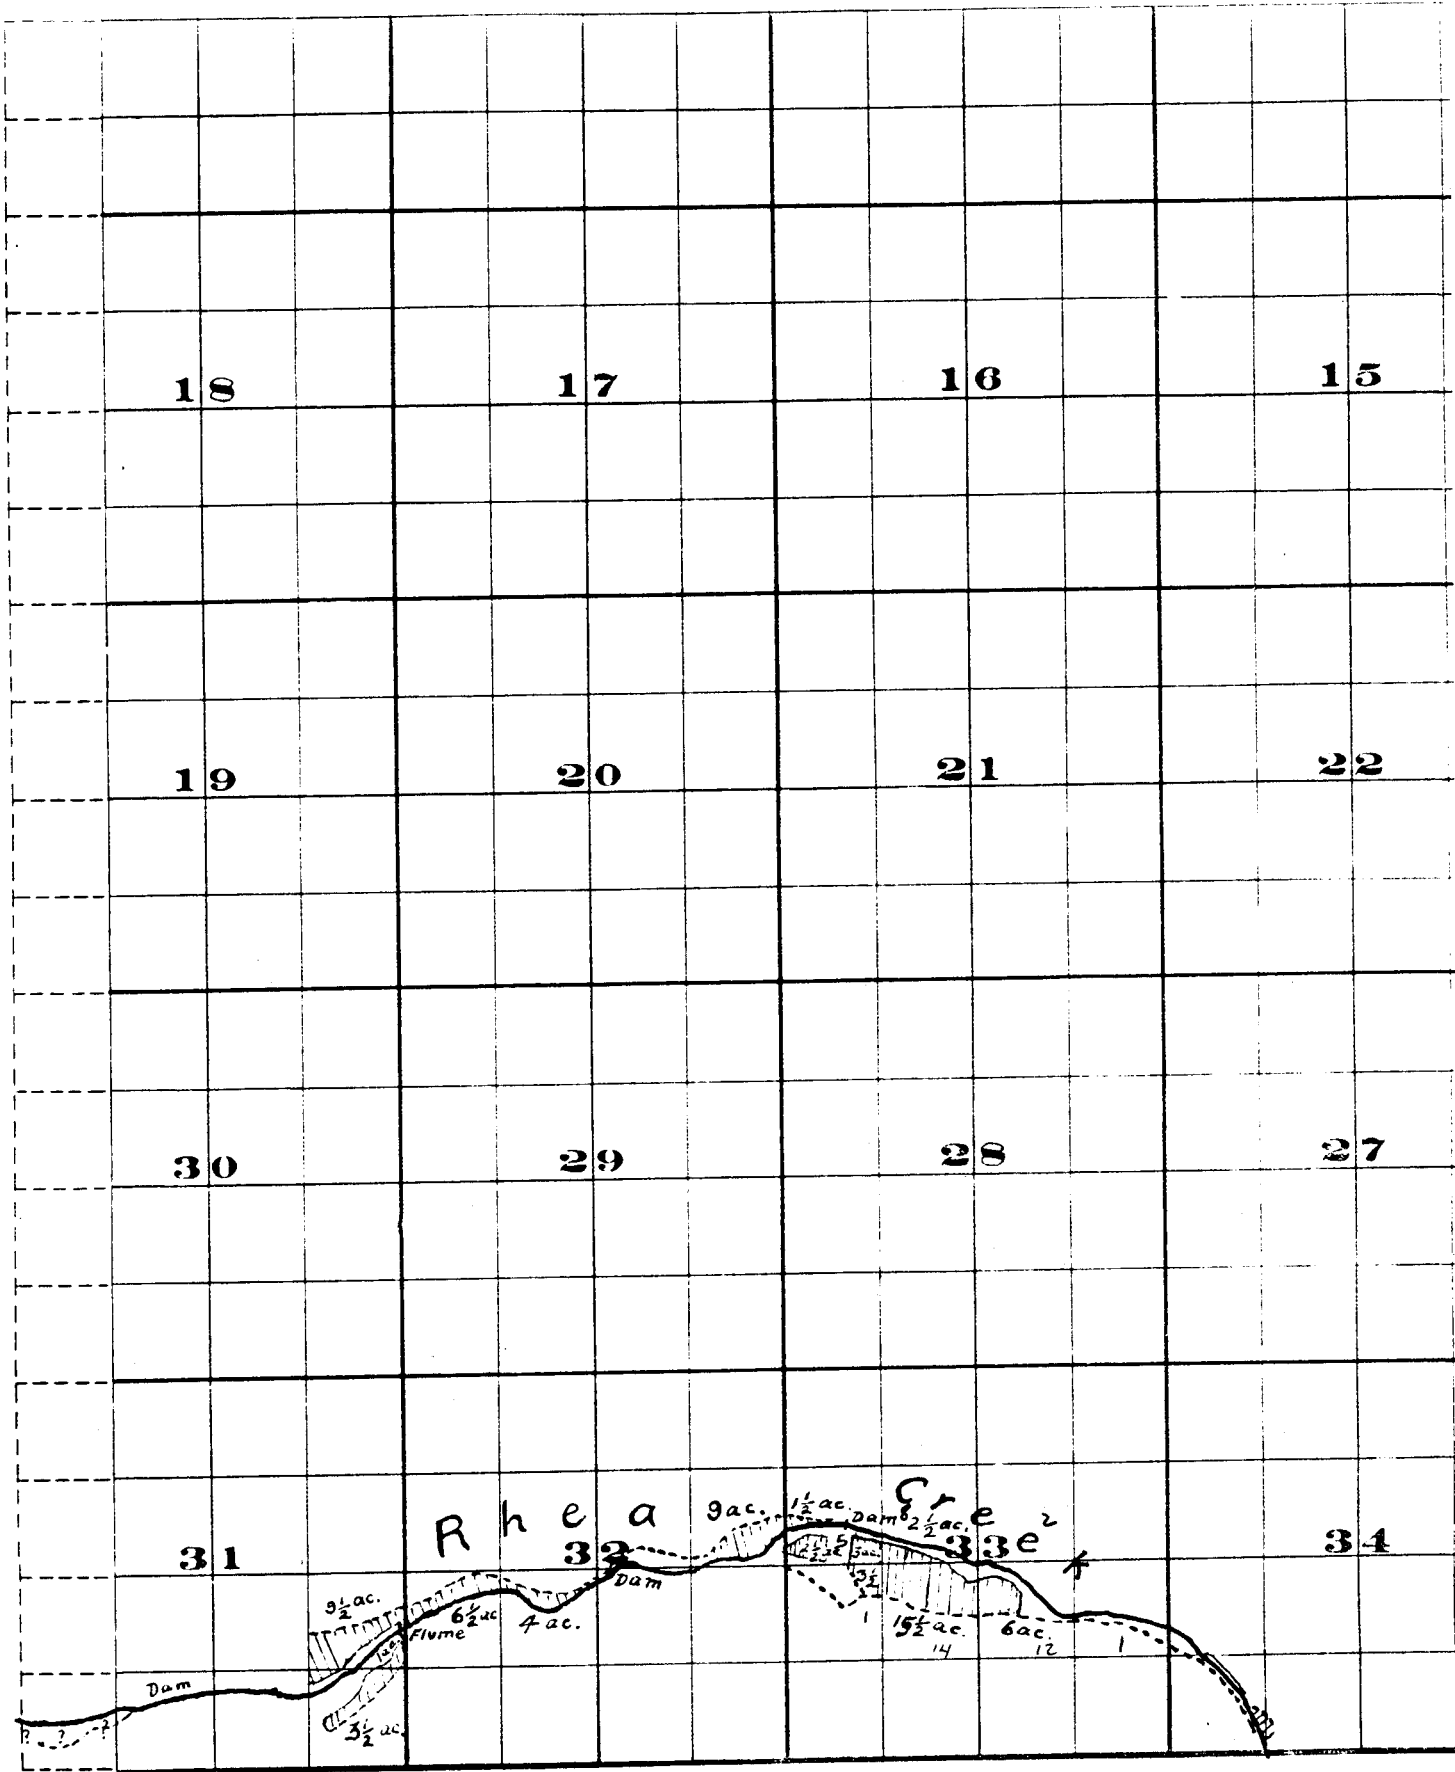


Surveyed by H.K. Donnelly July 1909

John H. Lewis - State Engineer

Examined - July 14, 1909.

	15			14				13	
	22			23				24	
	27			26				25	
	34			35				36	

FROM OFFICE OF THE STATE ENGINEER, SALEM, OREGON

Willow Creek Adjudication

3 S. 26 E.