


T.29 S., R.14 & 15 W.W.M.

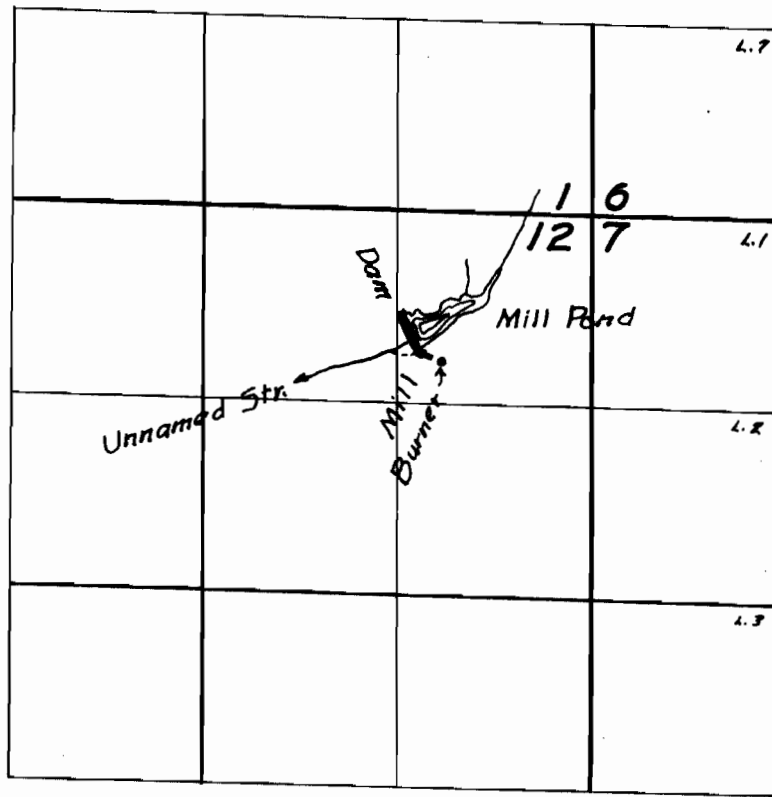

FINAL PROOF SURVEY

UNDER

R-23832

R-974

Application No. ~~23724~~ Permit No. ~~18735~~

IN NAME OF

MELVIN DAHL

Surveyed 16 March 1955, by H.L. Coffman