


T.29 S., R. 14 & 15 W.W.M.

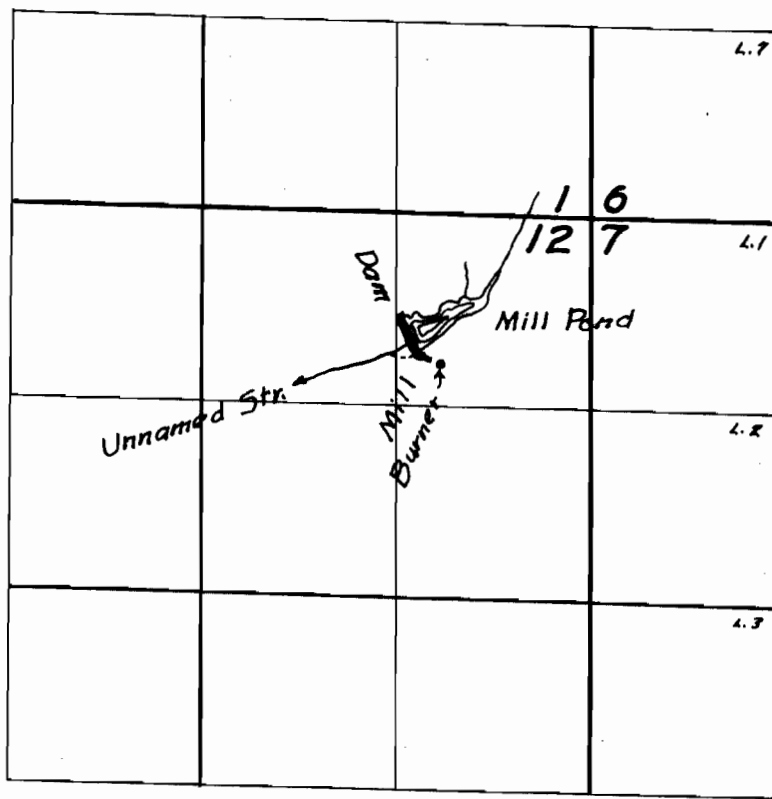

FINAL PROOF SURVEY

UNDER

R-23832

R-974

Application No. 23724 Permit No. 18735

IN NAME OF

MELVIN DAHL

Surveyed 16 March 1955, by H.L. Coffman