


T.15 S. R. 45 E. W.M.

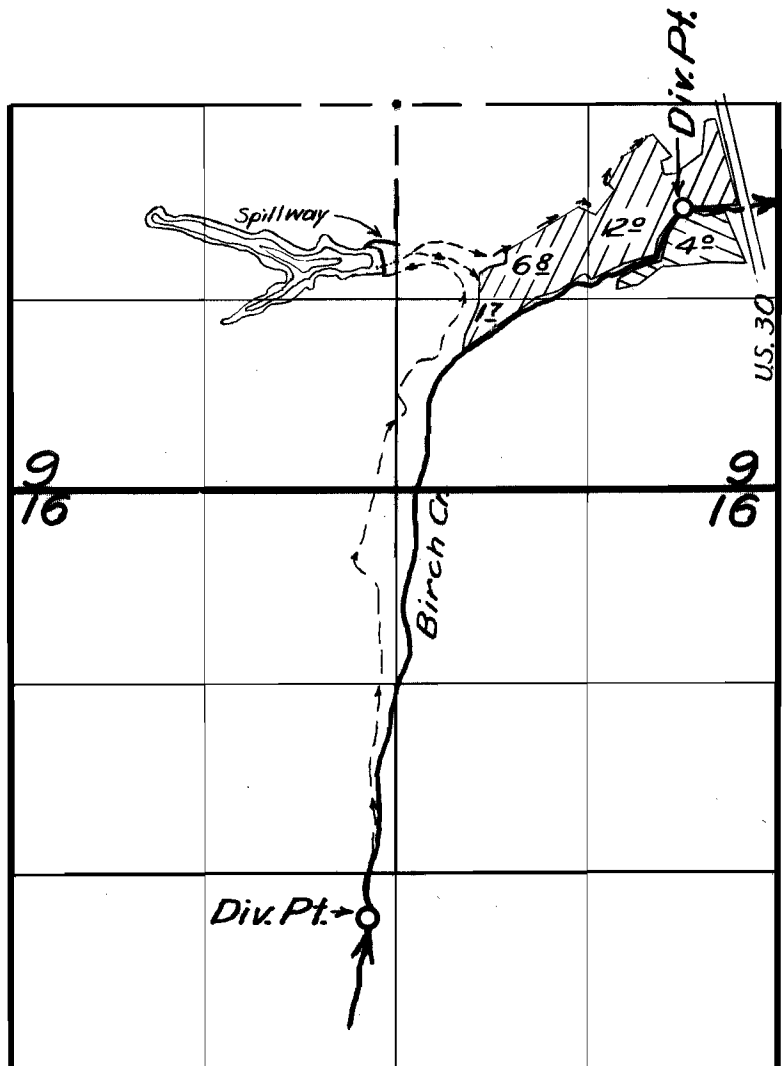

FINAL PROOF SURVEY

UNDER

R-25515

R-1110

Application No. 25516 Permit No. 20045

IN NAME OF

Burton D. Owens

Surveyed Oct. 30 1955, by M. Bish