


T. 3 N. R. 10 W. W. M.

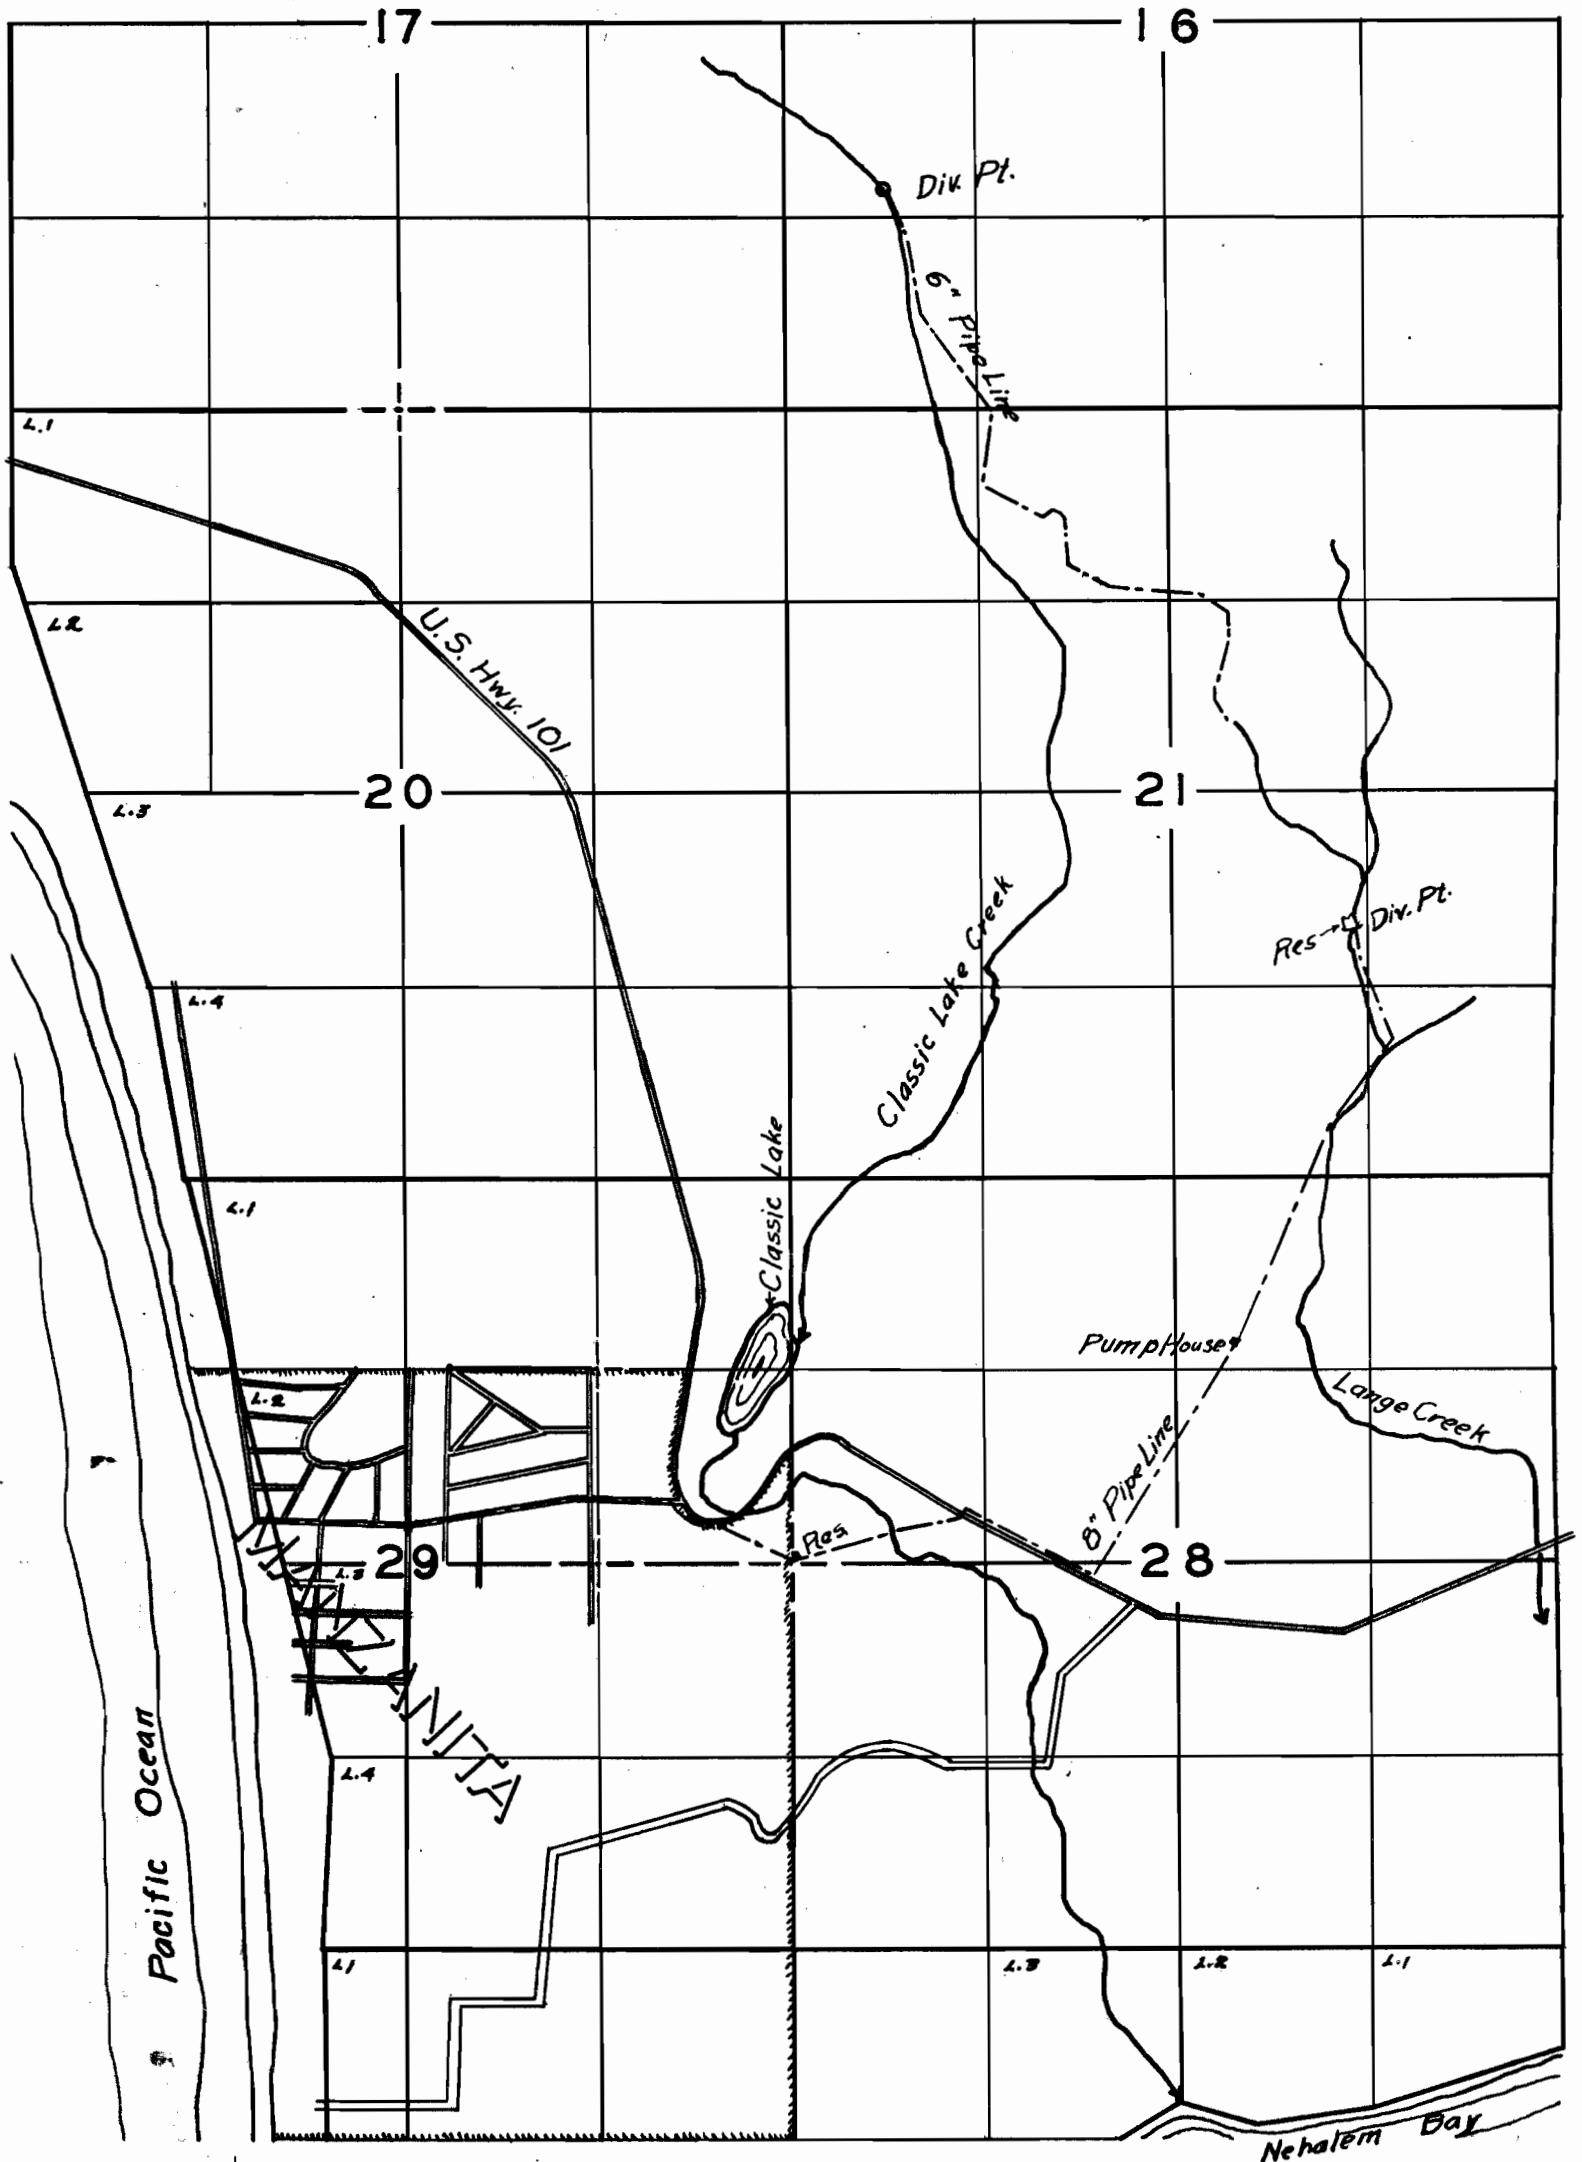

FINAL PROOF SURVEY

UNDER

APPLICATION NO. 23417, 25124, & R-26028 PERMIT NO. 18634, 21913 & R-1455
IN NAME OF

CITY OF MANZANITA

SURVEYED 5 AUGUST 1955, BY Robert B. Beck