


T6SR10WWM

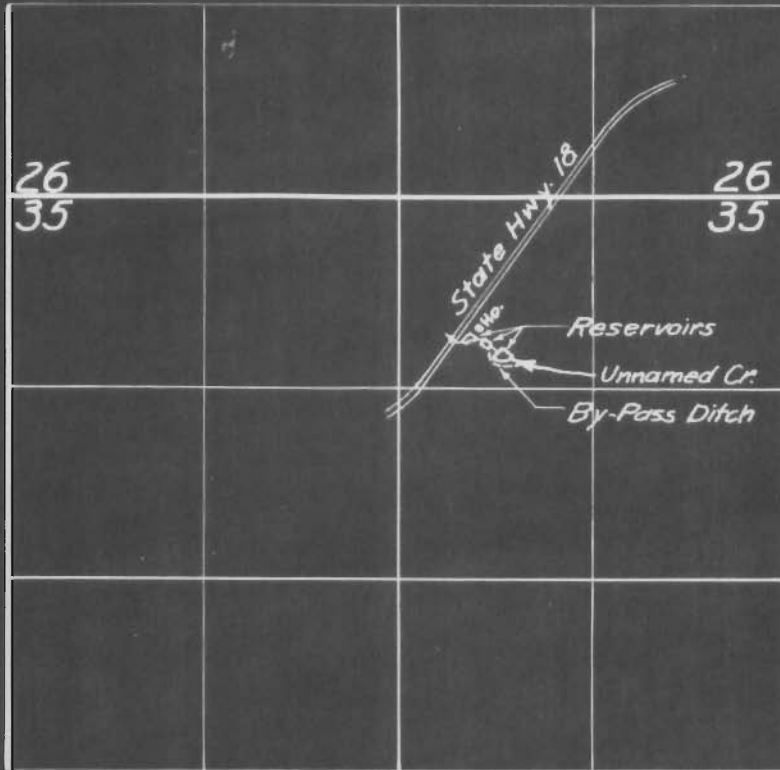

FINAL PROOF SURVEY

UNDER

Application No. R28793 28550 Permit No. R-1601 22814

IN NAME OF

Nels & Elizabeth Yenckel

Surveyed Aug 29 1955, by M. Bish