


T.2S. R.9 W.W.M.

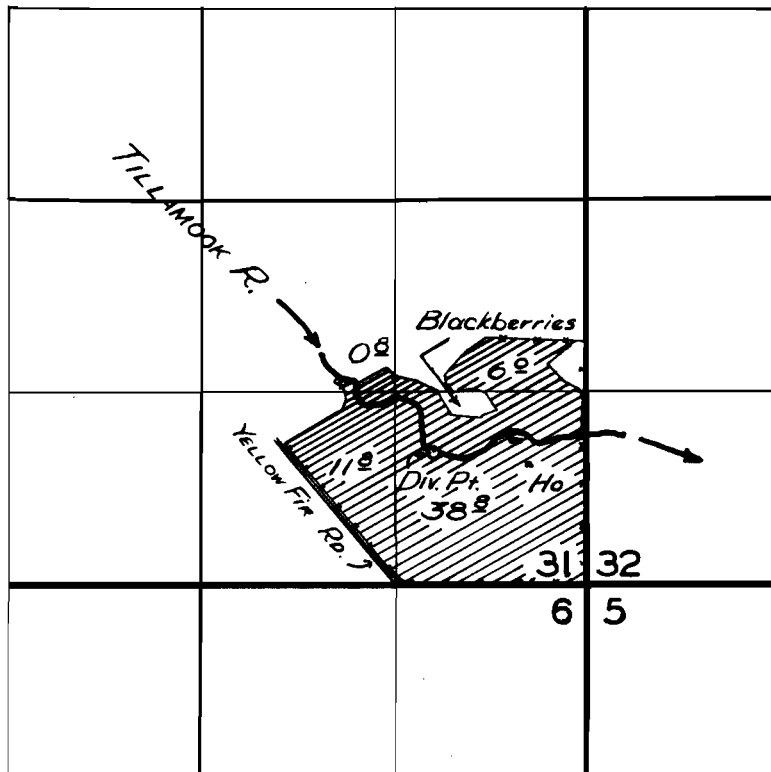

FINAL PROOF SURVEY

UNDER

Application No. 17765 Permit No. 13573

IN NAME OF

C.O. CURL

Surveyed 9 Aug. 1955, by

[Signature]