


T. 2 S. R. 2 E. W. M.

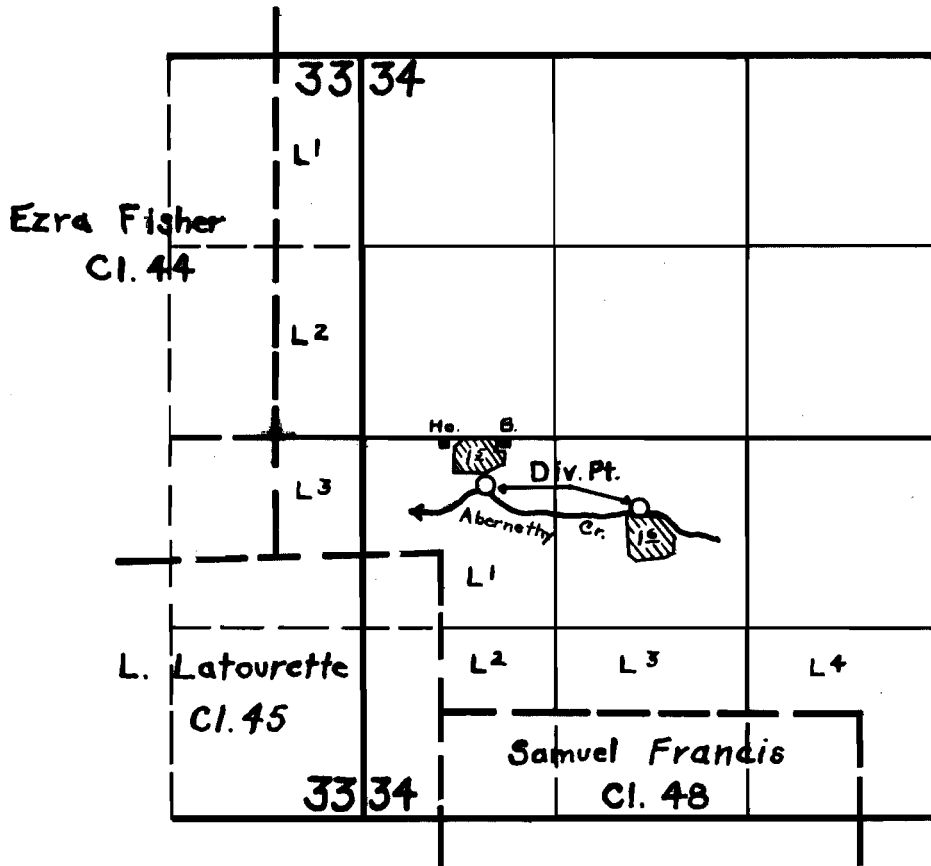

FINAL PROOF SURVEY

UNDER

Application No. 17995 Permit No. 13669

IN NAME OF

CLARENCE HITCHMAN

Surveyed 24 Oct. 1955, by M. Bish

DFK-3D-149