


T. 7 S. R. 11 W. W. M.

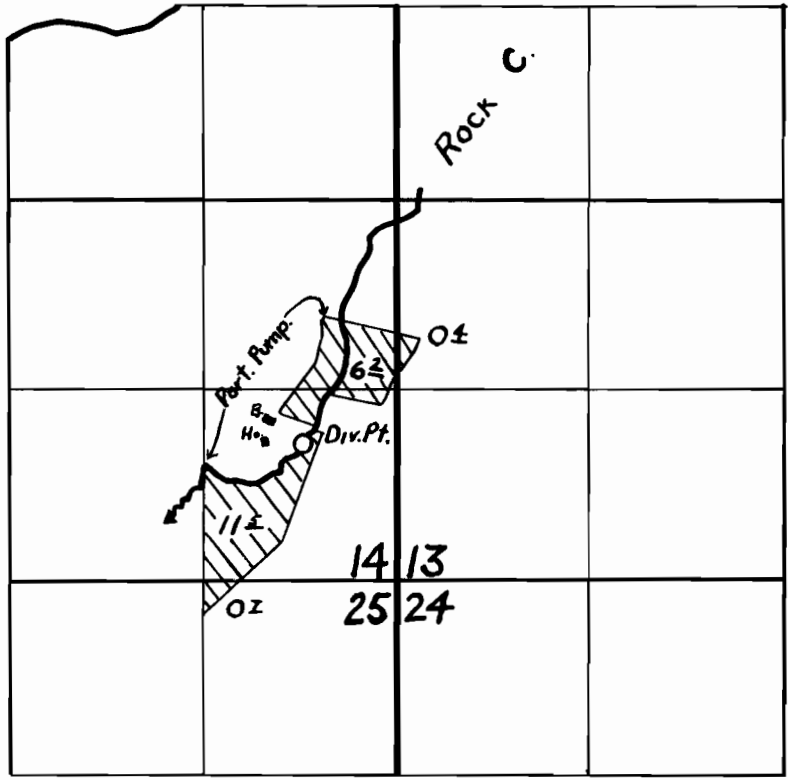

**FINAL PROOF SURVEY**  
UNDER

Application No. *18118* Permit No. *15873*  
IN NAME OF

**AMELIA HILL**

Surveyed *27 Apr. 1955*, by *H. Coffman*

*RWD*